


STATE OF KANSAS
STATE CORPORATION COMMISSION
CONSERVATION DIVISION
P. O. BOX 17027
WICHITA, KANSAS 67217

FORM CP-4

WELL PLUGGING RECORD

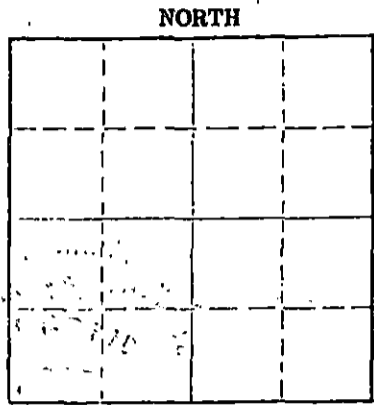

Kingman County, Sec. 15 Twp. 29S Rge. 7 (E) W (W)
Location as "NE/CNW&SW" or footage from lines. C S/2 NW/4 SE/4
Lease Owner. Robert F. White
Lease Name Whitelaw Well No. 3
Office Address 1014 Union Center; Wichita, Ks. 67202
Character of Well (completed as Oil, Gas or Dry Hole) Oil
Date well completed June 24 1959
Application for plugging filed January 7 1975
Application for plugging approved January 1975
Plugging commenced January 31 1975
Plugging completed February 14 1975
Reason for abandonment of well or producing formation No longer economic

If a producing well is abandoned, date of last production December 31 1974
Was permission obtained from the Conservation Division or its agents before plugging was commenced? Yes

Name of Conservation Agent who supervised plugging of this well Russell Biberstein
Producing formation Viola Depth to top 4496' Bottom 4504' Total Depth of Well 4504' F-1
Show depth and thickness of all water, oil and gas formations.

OIL, GAS OR WATER RECORDS

CASING RECORD

FORMATION	CONTENT	FROM	TO	SIZE	PUT IN	PULLED OUT
				8 5/8"	286	None
				5 1/2"	4496	3435

Describe in detail the manner in which the well was plugged, indicating where the mud fluid was placed and the method or methods used in introducing it into the hole. If cement or other plugs were used, state the character of same and depth placed, from feet to feet for each plug set.

January 31, 1975 Plugged off bottom. Dumped sand to 4300'. Mixed and dumped 5 sx of cement.
February 14, 1975 Plugged off top. Set 10' rock bridge at 240'. Filled 8 5/8" casing from 240' to base of cellar with 3000 lb. P.S.T. ready-mix concrete.


Name of Plugging Contractor RUSS CASING PULLING, INC.
Address P. O. Box 1082; Great Bend, Kansas 67530

STATE OF KANSAS COUNTY OF SEDGWICK ss.
Robert F. White

well being first duly sworn on oath, says: That I have knowledge of the facts, statements, and matters herein contained and the log of the above-described well as filed and that the same are true and correct. So help me God.

(Signature) Robert F. White
1014 Union Center, Wichita, Kansas 67202
(Address)

Subscribed and sworn to before me this 21st day of February 1975

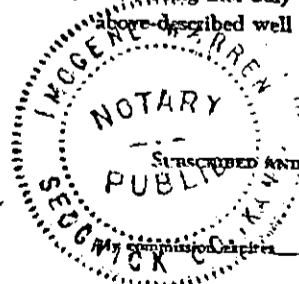

August 6, 1975 Imogene Warren Notary Public.

RECEIVED
STATE CORPORATION COMMISSION
JUN 24 1975 2-24-75
CONSERVATION DIVISION
Wichita, Kansas

WHITBLAW #3

W. J. Coppinger, et al.

Total Depth: 4504
Contractor: Rex & Morris Drilling Co.
Commenced: 6-5-59
Completed: 6-18-59

Location: - C. 8/2 NW/4 SE/4
Section 15-298-7W
Kingman County, Kansas

Casing Record:
8 5/8 @ 291' w/180 sacks
5 1/2 @ 4497' w/200 sacks

FORMATION	DEPTH
Surface Hole	291
Shells and Shale	1075
Shale and Lime	1470
Lime and Shale	1925
Shale and Lime	2450
Lime and Shale	2817
Lime and Shale	3160
Shale and Sand	3342
Lime and Shale	3380
Lime (Lansing)	3805
Lime and Shale	3940
Shale and Lime	4020
Lime and Shale	4131
Lime (Miss.)	4387
Lime and Shale	4497
Lime (Viola)	4504

R. T. D.

RECEIVED
STATE CORPORATION COMMISSION

JAN 8 1975

CONSERVATION DIVISION
Wichita, Kansas

I hereby certify the foregoing statements are true and correct to the best of my knowledge and belief.

Rex & Morris Drilling Company

By Paul D. Koontz
Paul D. Koontz, Geologist

STATE OF KANSAS
COUNTY OF BUTLER, SS.

Subscribed and sworn to before me, a Notary Public, this 19th day of June, 1959.

Elizabeth Deschner
Elizabeth Deschner, Notary Public

My commission expires: August 8, 1962.