

CONFIDENTIAL

SIDE ONE

KCC

STATE CORPORATION COMMISSION OF KANSAS  
OIL & GAS CONSERVATION DIVISION  
WELL COMPLETION FORM  
ACO-1 WELL HISTORY  
DESCRIPTION OF WELL AND LEASE

Operator: License # 04824  
Name: MESA OPERATING LTD. PARTNERSHIP  
Address P.O. BOX 2009  
City/State/Zip AMARILLO TX 79189  
Purchaser: TEXACO TRADING & TRANS  
Operator Contact Person: W. RIDDLE  
Phone ( 316 ) 356-3026


Contractor: Name: SERVICE DRILLING CO.  
License: 5987  
Wellsite Geologist: NONE

Designate Type of Completion  
 New Well  Re-Entry  Workover  
 Oil  SWD  Temp. Abd.  
 Gas  Inj  Delayed Comp.  
 Dry  Other (Core, Water Supply, etc.)

If OWO: old well info as follows:  
Operator: \_\_\_\_\_  
Well Name: \_\_\_\_\_  
Comp. Date \_\_\_\_\_ Old Total Depth \_\_\_\_\_

Drilling Method:  
 Mud Rotary  Air Rotary  Cable  
6-3-91 6-16-91 8-9-91  
Spud Date Date Reached TD Completion Date

API NO. 15- 189-21,497-0000 SEP 19  
County STEVENS **CONFIDENTIAL**  
C SW SW Sec. 13 Twp. 31 Rge. 35 X East West  
510 Ft. North from Southeast Corner of Section  
4792' Ft. West from Southeast Corner of Section  
(NOTE: Locate well in section plat below.)  
Lease Name MOREHEAD Well # 1-13  
Field Name LAHEY  
Producing Formation CHESTER  
Elevation: Ground 2961' KB 2972'  
Total Depth 5900' PBTD 5665'

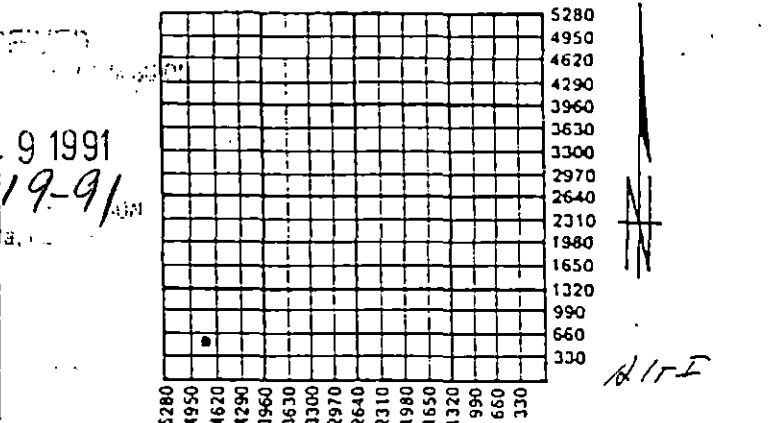

Amount of Surface Pipe Set and Cemented at 1836' Feet  
Multiple Stage Cementing Collar Used?  Yes  No  
If yes, show depth set \_\_\_\_\_ Feet  
If Alternate II completion, cement circulated from \_\_\_\_\_  
feet depth to \_\_\_\_\_ w/ \_\_\_\_\_ sx cmt.

INSTRUCTIONS: This form shall be completed in triplicate and filed with the Kansas Corporation Commission, 200 Colorado Derby Building, Wichita, Kansas 67202, within 120 days of the spud date of any well. Rule 82-3-130, 82-3-107 and 82-3-106 apply. Information on side two of this form will be held confidential for a period of 12 months if requested in writing and submitted with the form. See rule 82-3-107 for confidentiality in excess of 12 months. One copy of all wireline logs and drillers time log shall be attached with this form. ALL CEMENTING TICKETS MUST BE ATTACHED. Submit CP-4 form with all plugged wells. Submit CP-111 form with all temporarily abandoned wells. Any recompletion, workover or conversion of a well requires filing of ACO-2 within 120 days from commencement date of such work.

All requirements of the statutes, rules and regulations promulgated to regulate the oil and gas industry have been fully complied with and the statements herein are complete and correct to the best of my knowledge.

Signature Deana Q. [Signature]  
Title ADMINISTRATIVE CLERK Date \_\_\_\_\_  
Subscribed and sworn to before me this 18th day of September 1991.  
Notary Public Tammy Elliott  
Date Commission Expires 5-24-93

K.C.C. OFFICE USE ONLY  
F  Letter of Confidentiality Attached  
C  Wireline Log Received  
C  Drillers Timelog Received  
Distribution  
 KCC  SWD/Rep  NGPA  
 KGS  Plug  Other  
(Specify)

