

NP

STATE CORPORATION COMMISSION OF KANSAS
OIL & GAS CONSERVATION DIVISION

WELL COMPLETION OR RECOMPLETION FORM
ACO-1 WELL HISTORY

DESCRIPTION OF WELL AND LEASE

Operator: License # 3711
Name Shepler & Thomas, Inc.
Address P.O. Box 1162
City/State/Zip Liberal, Kansas 67905-1162

Purchaser: N/A

Operator Contact Person R. F. Burke
Phone (316) 624-0750

Contractor: License # 3098
Name Exeter Drilling Company

Wellsite Geologist Ed Nichols
Phone (316) 624-2623

Designate Type of Completion

- New Well
- Re-Entry
- Workover
- Oil
- Gas
- Dry
- SWD
- Inj
- Other (Core, Water Supply etc.)
- Temp Abd
- Delayed Completion

If OWNO: old well info as follows:

Operator
Well Name
Comp. Date Old Total Depth

WELL HISTORY

Drilling Method:

- Mud Rotary
- Air Rotary
- Cable

3-12-88	3-23-88	N/A
Spud Date	Date Reached TD	Completion Date
6002	5960	
Total Depth	PBTD	

Amount of Surface Pipe Set and Cemented at 1600 feet
 Multiple Stage Cementing Collar Used? Yes No
 If yes, show depth set.....feet
 If alternate 2 completion, cement circulated from.....feet depth to.....w/.....SX cmt

API NO. 15-175-21015-0000

County Seward

..... NW NW Sec. 31 Twp. 32S Rge. 31 East West


4620 Ft North from Southeast Corner of Section
4620 Ft West from Southeast Corner of Section
(Note: Locate well in section plat below)

Lease Name Elliott Well # 1-31

Field Name Wildcat Kismet

Producing Formation Unknown

Elevation: Ground 2789 KB 2801
Section Plat

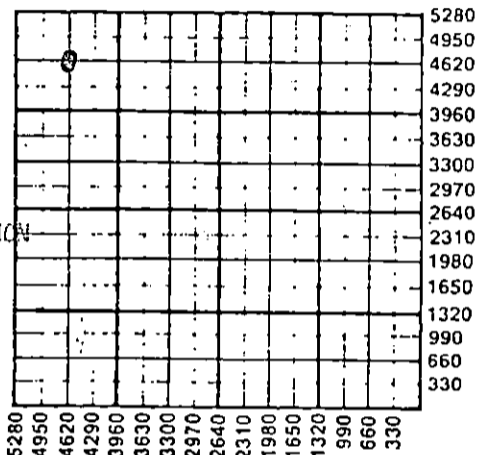

RECEIVED
STATE CORPORATION COMMISSION
JUL 12 1988
CONSERVATION DIVISION
Wichita, Kansas

WATER SUPPLY INFORMATION

Disposition of Produced Water: Disposal Repressuring
Docket #

Questions on this portion of the ACO-1 call:
Water Resources Board (913) 296-3717


Source of Water:
Division of Water Resources Permit #

- Groundwater.....Ft North from Southeast Corner (Well)Ft West from Southeast Corner of Sec Twp Rge East West
- Surface Water.....Ft North from Southeast Corner (Stream, pond etc).....Ft West from Southeast Corner Sec Twp Rge East West
- Other (explain) Hauled (purchased from city, R.W.D. #)

INSTRUCTIONS: This form shall be completed in duplicate and filed with the Kansas Corporation Commission, 200 Colorado Derby Building, Wichita, Kansas 67202, within 90 days after completion or recompletion of any well. Rule 82-3-130 and 82-3-107 apply.
 Information on side two of this form will be held confidential for a period of 12 months if requested in writing and submitted with the form. See rule 82-3-107 for confidentiality in excess of 12 months.
 One copy of all wireline logs and drillers time log shall be attached with this form. Submit CP-4 form with all plugged wells. Submit CP-111 form with all temporarily abandoned wells.

All requirements of the statutes, rules and regulations promulgated to regulate the oil and gas industry have been fully complied with and the statements herein are complete and correct to the best of my knowledge.

Signature R. F. Burke
Title Agent Date 7-11-88

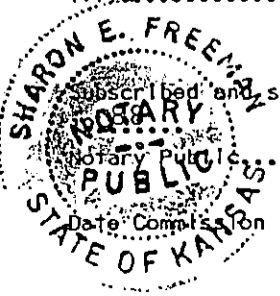

Subscribed and sworn to before me this 11th day of July
Sharon E. Freeman
Date Commission Expires 01-04-91

K.C.C. OFFICE USE ONLY

Letter of Confidentiality Attached
 Wireline Log Received
 Drillers Time Log Received

Distribution
 KCC SWD/Rep NGPA
 KGS Plug Other (Specify)

7-12-88