

STATE CORPORATION COMMISSION OF KANSAS
OIL & GAS CONSERVATION DIVISION

WELL COMPLETION OR RECOMPLETION FORM
ACO-1 WELL HISTORY

DESCRIPTION OF WELL AND LEASE

Operator: License # 3711
Name Shepler & Thomas, Inc.
Address P.O. Box 1162
City/State/Zip Liberal, KS 67905-1162

Purchaser: Petro-Source

Operator Contact Person R. F. Burke
Phone (316) 624-0750

Contractor: License # 3098
Name Exeter Drilling Company

Wellsite Geologist Don Huber
Phone (316) 624-8222

Designate Type of Completion

- New Well
- Re-Entry
- Workover
- Oil
- SWD
- Temp Abd
- Gas
- Inj
- Delayed Comp.
- Dry
- Other (Core, Water Supply etc.)

If OWWO: old well info as follows:

Operator
Well Name
Comp. Date
Old Total Depth

WELL HISTORY

Drilling Method:

- Mud Rotary
- Air Rotary
- Cable

3-21-88 3-27-88 4-6-88
Spud Date Date Reached TD Completion Date

6000 5973
Total Depth PBTD

Amount of Surface Pipe Set and Cemented at 1642 feet
Multiple Stage Cementing Collar Used? Yes No
If yes, show depth set.....feet
If alternate 2 completion, cement circulated from.....feet depth to.....w/.....SX cmt
A/I

API NO. 15-175-21016-0000

County Seward

SE NE Sec. 30 Twp. 32 Rge. 31 East West

3300 Ft North from Southeast Corner of Section
660 Ft West from Southeast Corner of Section

(Note: Locate well in section plat below)


Lease Name Stoll Well # 1-30

Field Name Wildcat MASSONI, NW

Producing Formation Marmaton

Elevation: Ground 2778 KB 2789

Section Plat

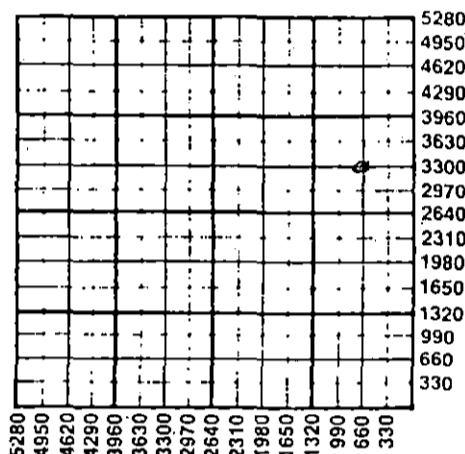

WATER SUPPLY INFORMATION

Disposition of Produced Water: Disposal Repressuring
Docket #

Questions on this portion of the ACO-1 call:

Water Resources Board (913) 296-3717

Source of Water:

Division of Water Resources Permit #

Groundwater.....Ft North from Southeast Corner (Well)Ft West from Southeast Corner of Sec Twp Rge East West

Surface Water.....Ft North from Southeast Corner (Stream, pond etc).....Ft West from Southeast Corner Sec Twp Rge East West

Other (explain) Hauled (purchased from city, R.W.D. #)

INSTRUCTIONS: This form shall be completed in duplicate and filed with the Kansas Corporation Commission, 200 Colorado Derby Building, Wichita, Kansas 67202, within 90 days after completion or recompletion of any well. Rule 82-3-130 and 82-3-107 apply.

Information on side two of this form will be held confidential for a period of 12 months if requested in writing and submitted with the form. See rule 82-3-107 for confidentiality in excess of 12 months.

One copy of all wireline logs and drillers time log shall be attached with this form. Submit CP-4 form with all plugged wells. Submit CP-111 form with all temporarily abandoned wells.

All requirements of the statutes, rules and regulations promulgated to regulate the oil and gas industry have been fully complied with and the statements herein are complete and correct to the best of my knowledge.

Signature R.F. Burke
Title Agent Date 6/1/88

K.C.C. OFFICE USE ONLY

Letter of Confidentiality Attached
 Wireline Log Received
 Drillers Timelog Received

Distribution

KCC SWD/Rep NGPA
 KGS Plug Other (Specify)

6-2-88



Subscribed and sworn to before me this 1st day of June 1988
Sharon E. Freeman
Notary Public
Date Commission Expires 01-04-91

MR-3891

Sec. 30 Twp. 32 Rge. 31 E