

STATE CORPORATION COMMISSION OF KANSAS
OIL & GAS CONSERVATION DIVISION

WELL COMPLETION OR RECOMPLETION FORM
ACO-1 WELL HISTORY

DESCRIPTION OF WELL AND LEASE

Operator: license # 8060
name Zinke & Trumbo, Ltd.
address 111 W. 5th, Suite 220
City/State/Zip Tulsa, Okla. 74103

Operator Contact Person Ron F. Crowell
Phone 918-592-5096

Contractor: license # 6333
name DaMac Drilling, Inc.

Wellsite Geologist Jim Milne
Phone 918-592-5096

Designate Type of Completion
 New Well Re-Entry Workover

Oil SWD Temp Abd
 Gas Inj Delayed Comp.
 Dry Other (Core, Water Supply etc.)
Re-Entry

If OWWO: old well info as follows:
Operator
Well Name
Comp. Date Old Total Depth

WELL HISTORY

Drilling Method: Mud Rotary Air Rotary Cable
10/15/85 10/27/85 10/29/85
Spud Date Date Reached TD Completion Date

6300! N/A
Total Depth PBDT

Amount of Surface Pipe Set and Cemented at 1520 feet

Multiple Stage Cementing Collar Used? Yes No

If Yes, Show Depth Set feet

If alternate 2 completion, cement circulated from feet depth to w/ SX cmt

API NO. 15- 119-20,72100 00
County Meade
SE NW NW Sec 3 Twp 35S Rge 26
(location) 4290 Ft North from Southeast Corner of Section
4290 Ft West from Southeast Corner of Section
(Note: locate well in section plat below)


Lease Name Wyatt Ranch Well# 1-3

Field Name McKinney

Producing Formation dry hole

Elevation: Ground 2308' KB 2317'

Section Plat

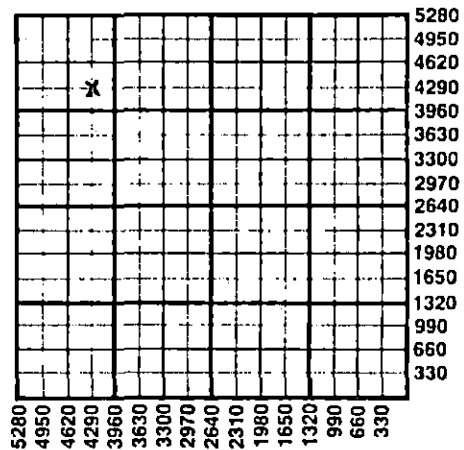

WATER SUPPLY INFORMATION

Source of Water:

Division of Water Resources Permit #

Groundwater Ft North From Southeast Corner and
(Well) Ft. West From Southeast Corner of
Sec Twp Rge East West

Surface Water Ft North From Southeast Corner and
(Stream, Pond etc.) Ft West From Southeast Corner
Sec Twp Rge East West

Other (explain) (purchased from city, R.W.D.#)

Disposition of Produced Water: Disposal Repressuring

Docket #

INSTRUCTIONS: This form shall be completed in duplicate and filed with the Kansas Corporation Commission, 200 Colorado Derby Building, Wichita, Kansas 67202, within 90 days after completion or recompletion of any well. Rules 82-3-130 and 82-3-107 apply.

Information on side two of this form will be held confidential for a period of 12 months if requested in writing and submitted with the form. See rule 82-3-107 for confidentiality in excess of 12 months.

One copy of all wireline logs and drillers time log shall be attached with this form. Submit CP-4 form with all plugged wells. Submit CP-111 form with all temporarily abandoned wells.

All requirements of the statutes, rules, and regulations promulgated to regulate the oil and gas industry have been fully complied with and the statements herein are complete and correct to the best of my knowledge.

Signature Ron F. Crowell
Title Prod. Mgr.
Date 11-25-85

Subscribed and sworn to before me this 22 day of November 1985
Notary Public Sheila R. McGraw
Date Commission Expires June 7, 1987

K.C.C. OFFICE USE ONLY
 Letter of Confidentiality Attached
 Wireline Log Received
 Drillers Timelog Received
Distribution
 KCC SWD/Rep NGPA
 KGS Plug Other (Specify)

Form ACO-1 (This form supercedes previous forms ACO-1 & C-10)
DEC 5 1985
12-30-85
KANSAS CORPORATION COMMISSION
Wichita, Kansas

Sec. 3, Twp. 35S, Rge. 26E