

WC Disc

STATE CORPORATION COMMISSION OF KANSAS  
OIL & GAS CONSERVATION DIVISION

WELL COMPLETION OR RECOMPLETION FORM  
ACO-1 WELL HISTORY

DESCRIPTION OF WELL AND LEASE

Operator: License # 5181  
Name DONALD C. SLAWSON  
Address 200 Douglas Building  
City/State/Zip Wichita, Kansas 67202

Purchaser Inland Purchasing & Transporting

Operator Contact Person Bill Horigan  
Phone (316) 263-3201

Contractor: License # 5656  
Name R.R.A. Inc.

Wellsite Geologist Jeff Stewart  
Phone (316) 263-3201

Designate Type of Completion

- New Well  Re-Entry  Workover
- Oil  SWD  Temp Abd
- Gas  Inj  Delayed Comp.
- Dry  Other (Core, Water Supply etc.)

If OWWO: old well info as follows:

Operator  
Well Name  
Comp. Date Old Total Depth

WELL HISTORY

Drilling Method:

- Mud Rotary  Air Rotary  Cable

7/12/85 7/29/85 8/15/85  
Spud Date Date Reached TD Completion Date  
3740' 3687'  
Total Depth PBTD

Amount of Surface Pipe Set and Cemented at 205 feet  
Multiple Stage Cementing Collar Used?  Yes  No  
If yes, show depth set... feet  
If alternate 2 completion, cement circulated  
from... feet depth to... w/... SX cmt

API NO. 15-173-20,715-0000

County Sedgwick

W/2<sup>60</sup> NW NW Sec. 12 Twp. 29 Rge. 1  East  West


4680' Ft North from Southeast Corner of Section  
4950' Ft West from Southeast Corner of Section  
(Note: Locate well in section plat below)

Lease Name Fenster C Well # 1

Field Name Wildcat Fenster

Producing Formation Mississippi

Elevation: Ground 1288 KB 1295  
Section Plat

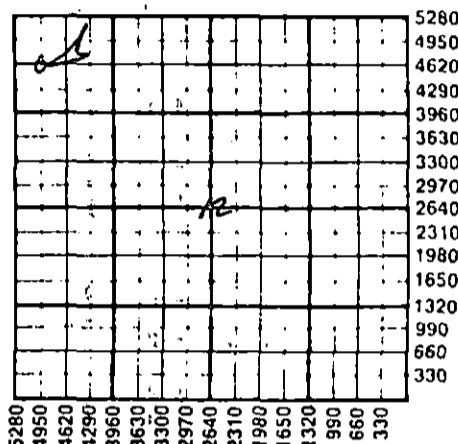

WATER SUPPLY INFORMATION

Disposition of Produced Water:  Disposal  Repressuring  
Docket #

Questions on this portion of the ACO-1 call:  
Water Resources Board (913) 296-3717

Source of Water:  
Division of Water Resources Permit #

Groundwater... Ft North from Southeast Corner  
(Well) ... Ft West from Southeast Corner  
Sec Twp Rge  East  West

Surface Water... Ft North from Southeast Corner  
(Stream, pond etc.) ... Ft West from Southeast Corner  
Sec Twp Rge  East  West

Other (explain):  
(purchased from city, R.W.D. #)

INSTRUCTIONS: This form shall be completed in duplicate and filed with the Kansas Corporation Commission, 200 Colorado Derby Building, Wichita, Kansas 67202, within 90 days after completion or recompletion of any well. Rule 82-3-130 and 82-3-107 apply.

Information on side two of this form will be held confidential for a period of 12 months if requested in writing and submitted with the form. See rule 82-3-107 for confidentiality in excess of 12 months. One copy of all wireline logs and drillers time log shall be attached with this form. Submit CP-4 form with all plugged wells. Submit CP-111 form with all temporarily abandoned wells.

All requirements of the statutes, rules and regulations promulgated to regulate the oil and gas industry have been fully complied with and the statements herein are complete and correct to the best of my knowledge.

Signature William R. Horigan  
Title Kansas Operations Manager Date 8/27/85

Subscribed and sworn to before me this 27 day of August 1985  
Notary Public Leslie K. Robinson  
Date Commission Expires 5-27-89

K.C.C. OFFICE USE ONLY  
 Letter of Confidentiality Attached  
 Wireline Log Received  
 Drillers Timelog Received  
Distribution  
 KCC  SWD/Rep  NGPA  
 KGS  Plug  Other (Specify)



RECEIVED  
STATE CORPORATION COMMISSION (7-84)  
Form 1000  
SEP 16 1985 9-16-85  
CONSERVATION

Operator Name DONALD C. SLAWSON Lease Name Fenster-C Well # 12  
Sec. 12 Twp. 29S Rge. 1 East West County Sedgwick

WELL LOG

INSTRUCTIONS: Show important tops and base of formations penetrated. Detail all cores. Report all drill stem tests giving interval tested, time tool open and closed, flowing and shut-in pressures, whether shut-in pressure reached static level, hydrostatic pressures, bottom hole temperature, fluid recovery, and flow rates if gas to surface during test. Attach extra sheet if more space is needed. Attach copy of log.

Drill Stem Tests Taken [X] Yes [ ] No  
Samples Sent to Geological Survey [X] Yes [ ] No  
Cores Taken [ ] Yes [X] No

Formation Description [X] Log [ ] Sample

DST #1 2741-2810' (Top Zn, 140' & 160')  
30-60-45-75, BOBOB, 495' TF (185'M, 124'WM  
186' SOsptdM) IFP 31-136#, FFP 146-240#,  
ISIP 1168#, FSIP 1157#, HP 1459-1376#  
DST #2 2844-2860' 30-60-45-75, 1st op: 3" blw  
2ndop: 6" blw, Rec: 525' GIP, 92' TF  
(30% HOsptdM) 62' HOCM (35% O), IFP 11-21#  
FFP 31-52#, ISIP 1157#, FSIP 1157#,  
HP 1397-1407#  
DST #3 3257-3266' (Miss) 30-60-60-75  
BOBOB imm. GTS 22" into 1st op. OTS 39"  
into 2nd op., Rec: 5'CGO, 62' HOCM, rev.  
out 3101' fluid. flowed 23 BOPH,  
IFP 198-397#, FFP 397-626#, ISIP 1721#  
FSIP 1648#, HP 1627-1627#

Table with 3 columns: Name, Top, Bottom. Rows include KC, STK, BKC, CK, MISS, DOLO, KIND, SIMP, ARB, LTD with corresponding depth values.

RELEASED

DEC 22 1987

FROM CONFIDENTIAL

CASING RECORD, PERFORATION RECORD, TUBING RECORD, Date of First Production, Estimated Production. Includes fields for Purpose of String, Size Hole, Setting Depth, and Production Method.

METHOD OF COMPLETION

Disposition of gas: [X] Vented [ ] Open Hole [X] Perforation [ ] Sold [ ] Other (Specify) [ ] Used on Lease

Production Interval

3259' - 81'

Quality Completed [ ] Commingled [ ]

# CONFIDENTIAL

ACO-1  
Page 3  
DONALD C. SLAWSON  
Fenster C #1  
API#15-173-20,715  
W/2 NW NW Sec. 12-29S-1W  
Sedgwick County, Kansas

CONFIDENTIAL

DST #4 3266-3286' (Miss) 30-85-45-75  
BOBOB imm. GTS 12" 1st op, OTS imm., flowed & rev. out 69 BBLS oil 2nd op  
Rec: 102' GIP, 20' foamy OCM  
IFP 449-1001#, FFP 751-970#, ISIP 1658#, FSIP 1564#, HP 1784-1753#

DST #5 3286-3314' (Miss) 30-60-45-75  
Blw built to BOB in 27"  
Rec: 62' GIP, 340' TF, 216' sl Gsy Mud w/scum of oil,  
124' MW, IFP 31-94#, FFP 115-188#, ISIP 1732#, FSIP 1721#, HP 1816-1784#

DST #6 3560-3585' (Simp) 30-60-45-75  
Blow built to 4"  
Rec: 260' Mud  
IFP 21-73#, FFP 94-167#, ISIP 1418#, FSIP 1418#, HP 2025-1941#

NOV 19 1985  
State Geological Survey  
WICHITA BRANCH

RELEASED

DEC 24 1987

FROM CONFIDENTIAL

RECEIVED  
STATE CORPORATION COMMISSION

SEP 16 1985

CONSERVATION DIVISION  
Wichita, Kansas