

STATE CORPORATION COMMISSION OF KANSAS  
OIL & GAS CONSERVATION DIVISION  
WELL COMPLETION OR RECOMPLETION FORM  
ACO-1 WELL HISTORY  
DESCRIPTION OF WELL HISTORY

Operator: License # 5208  
Name MOBIL OIL CORPORATION  
Address P.O. BOX 5444

City/State/Zip DENVER, COLORADO 80217

Purchaser SOLD ON SPOT MARKET, TRANSPORTER  
WILLIAMS BROS.

Operator Contact Person B. R. HAYNARD  
Phone (303) 298-2069

Contractor: License # 9137  
Name UNIT DRILLING & EXPLORATION CO.

Wellsite Geologist DRAN DUBOIS  
Phone (303) 298-3742

Designate Type of Completion  
XX New      \_\_\_ Re-Entry      \_\_\_ Workover  
  
\_\_\_ Oil      \_\_\_ SWD      \_\_\_ Temp Abd  
XX Gas      \_\_\_ Inj      \_\_\_ Delayed Comp.  
\_\_\_ Dry      \_\_\_ Other (Core, Water Supply, etc.)  
If OWWO: old well info as follows;  
Operator \_\_\_\_\_  
Well Name \_\_\_\_\_  
Comp. Date \_\_\_\_\_


WELL HISTORY

Drilling Method:  
XX Mud Rotary      \_\_\_ Air Rotary      \_\_\_ Cable  
  
3/10/89      3/17/89      3/25/89  
Spud Date      Date Reached TD      Completion Date  
  
6237'      6188'  
Total Depth      PBD  
*1172*  
  
Amount of Surface Pipe Set and Cemented at 1803 feet  
Multiple Stage Cementing Collar Used? XX Yes      \_\_\_ No  
If yes, show depth set 3240 feet  
If alternate 2 completion, cement circulated  
from NA feet depth to \_\_\_\_\_ w/ SX cement  
Cement Company Name HOWCO  
Invoice # \_\_\_\_\_

API No. 15- 189-21320-0000  
COUNTY STEVENS  
APPROX C NW Sec 17 Twp 31S Rge 35 X East  
3960 Ft North from Southeast Corner of Section  
4111 Ft West from Southeast Corner of Section  
(Note: Locate well in section plat below)

Lease Name JUANITA F. PHILLIPS UNIT WELL # 5  
Field Name CAVE, WEST *Panoma Gas Area*  
Producing Formation MORROW  
Elevation: Ground 2991' KB 3007'

SECTION PLAT

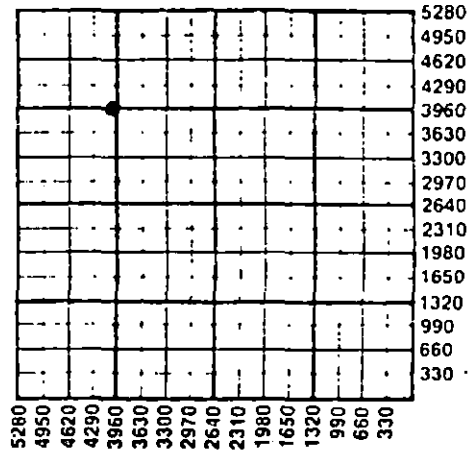

WATER SUPPLY INFORMATION

Disposition of Produced Water: XX Disposal  
Docket # 11793 \_\_\_ Repressuring

Questions on this portion of ACO-1 call:  
Water Resources Board (913) 296-3717  
Source of Water:  
Division of Water Resources Permit # T 89-115  
  
XX Groundwater 2575 Ft. North from Southeast Corner  
(well) 5150 Ft. West from Southeast Corner of  
Sec 17 Twp 31S Rge 35 East X West  
  
\_\_\_ Surface Water \_\_\_ Ft. North from Southeast Corner  
(Stream, pond etc) \_\_\_ Ft. West from Southeast Corner  
Sec \_\_\_ Twp \_\_\_ Rge \_\_\_ East \_\_\_ West  
  
\_\_\_ Other (explain) \_\_\_\_\_  
(purchased from city, R.W.D. #)

INSTRUCTIONS: This form shall be completed in triplicate and filed with the Kansas Corporation Commission, 200 Colorado Derby Building, Wichita, Kansas 67202, within 120 days of the spud date of any well. Rule 82-3-130, 82-3-107, and 82-3-106 apply.  
Information on side two of this form will be held confidential for a period of 12 months if requested in writing and submitted with the form. See rule 82-3-107 for confidentiality in excess of 12 months.  
One copy of all wireline logs and drillers time log shall be attached with this form. Submit 82-3-111 with all plugged wells. Submit cp-111 from with all temporarily abandoned wells.

All requirements of statutes, rules and regulations promulgated to regulate the oil and gas industry have been fully complied with and the statements herein are complete and correct to the best of my knowledge.

Signature B. R. Haynard B. R. HAYNARD  
Title REGULATORY COMPLIANCE MANAGER Date 5-22-89

Subscribed and sworn to before me this 22nd day of May  
Notary Public George George  
Date Commission Expires 1/3/91

K.C.C. OFFICE USE ONLY  
 Letter of Confidentiality Attached  
 Wireline Log Received  
 Drillers Time Log Received  
Distribution  
 KCC      \_\_\_ SWD/Rep      \_\_\_ NGPA  
 VGS      \_\_\_ Plug      \_\_\_ Other  
(Specify)  
5-24-89