

KANSAS

15-129-20454-0000

Interstate "F" No. 3
Exhibit B

WELL COMPLETION REPORT AND
DRILLER'S LOG

API No. 15 — 129 — 20,454
County Number


S. 20 T. 34S R. 43
Loc. 1650' FSL & 1250' FEL

Operator: Anadarko Production Company
Address: P. O. Box 351, Liberal, Kansas 67901
Well No. 3 Lease Name INTERSTATE "F"
Footage Location: 1650 feet from (S) line 1250 feet from (E) line
Principal Contractor: KTM Drilling Company Geologist: John Jacobson
Spud Date: 12/5/80 Date Completed: 12/21/80 Total Depth: 1330' P.B.T.D.: 1310'
Directional Deviation: not applicable Gas Purchaser: Panhandle Eastern Pipeline Co.

RECEIVED
KANSAS CORPORATION COMMISSION
1-18-95

JAN 18 1995

County Morton

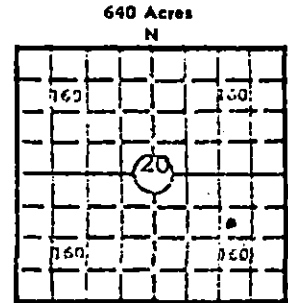

Locate well correctly
Elev.: Gr. 3476'
DF 3480' KB 3481'

CASING RECORD

Report of all strings set — surface, intermediate, production, etc.

Purpose of string	Size hole drilled	Size casing set (in O.D.)	Weight lbs/ft.	Setting depth	Type cement	Sacks	Type and percent additives
Surface	12-1/4"	8-5/8"	20#	378	Common	350	3% CaCl
Production	7-7/8"	4-1/2"	10.5#	1324'	Lite-wate SS Pozmix	350 150	.5% tic .5% tic

LINER RECORD

PERFORATION RECORD

Top, ft.	Bottom, ft.	Sacks cement	Shots per ft.	Size & type	Depth interval
			2	.46	1179-1210' O.A.

TUBING RECORD

Size	Setting depth	Packer set at
2-3/8"	1148'	

ACID, FRACTURE, SHOT, CEMENT SQUEEZE RECORD

Amount and kind of material used.	Depth interval treated
A/1300 gal 15% Spearhead + 75 BS	1179-1210' O.A.

INITIAL PRODUCTION

Date of first production: SI for Pipeline Conn
Producing method (flowing, pumping, gas lift, etc.): Flowing
RATE OF PRODUCTION PER 24 HOURS: Oil --- bbls. Gas 164 MCF Water --- bbls. Gas-oil ratio --- CFPB
Disposition of gas (vented, used on lease or sold): to be sold
Producing interval (s): 1179-1210' O.A.

INSTRUCTIONS: As provided in KCC Rule 82-2-125, within 90 days after completion of a well, one completed copy of this Drillers Log shall be transmitted to the State Geological Survey of Kansas, 4150 Monroe Street, Wichita, Kansas 67209. Copies of this form are available from the Conservation Division, State Corporation Commission, 245 No. Water, Wichita, Kansas 67202. Phone AC 316-522-2206. If confidential custody is desired, please note Rule 82-2-125. Drillers Logs will be on open file in the Oil and Gas Division, State Geological Survey of Kansas, Lawrence, Kansas 66044.

15-129-20454-0000

Operator Anadarko Production Company		DESIGNATE TYPE OF COMP.: OIL, GAS, DRY HOLE, SWDW, ETC.:
Well No. 3	Lease Name INTERSTATE "F"	GAS
S 20 T 34S R 43 & W		

WELL LOG

Show all important zones of porosity and contents thereof; cased intervals, and all drill-stem tests, including depth interval tested, cushion used, time tool open, flowing and shut-in pressures, and recoveries.

SHOW GEOLOGICAL MARKERS, LOGS RUN, OR OTHER DESCRIPTIVE INFORMATION.

FORMATION DESCRIPTION, CONTENTS, ETC.	TOP	BOTTOM	NAME	DEPTH
Sand & Shale	0'	158'		
Sand Red Clay	158'	383'		
Sand & Clay	383'	478'		
Sand Clay	478'	594'		
Red Clay & Red Shale	594'	655'		
Anhydrite & Redbed	655'	765'		
Glorietta	765'	1095'		
Red Shale & Anhydrite	1095'	1265'		
Red Shale sand	1265'	1330'		

RECEIVED
KANSAS CORPORATION COMMISSION

JAN 18 1995

CONSERVATION DIVISION
WICHITA, KS

USE ADDITIONAL SHEETS, IF NECESSARY, TO COMPLETE WELL RECORD.

Date Received	<p><i>Paul Campbell</i> Signature</p> <p>Paul Campbell, Division Production Manager Title</p> <p>December 22, 1980 Date</p>
---------------	---