

This form shall be filed in duplicate with the Kansas Corporation Commission, 200 Colorado Derby Building, Wichita, Kansas 67202, within ten days after the completion of the well, regardless of how the well was completed.

Attach separate letter of request if the information is to be held confidential. If confidential, only file one copy. Information on side one will be of public record and side two will then be held confidential.

Circle one: Oil, Gas, Dry, SWD, OWWO, Injection. Type and complete ALL sections. Applications must be filed for dual completion, commingling, SWD and injection, T.A.

Attach wireline logs (i.e. electrical log, sonic log, gamma ray neutron log, etc.). KCC # (316) 263-3238. (Rules 82-2-105 & 82-2-125)

OPERATOR PETRO-DYNAMICS, LTD.

API NO. 15-095-21,191-00-00

ADDRESS 555 N. WOODLAWN, BLDG. 1, SUITE 207 WICHITA, KS 67208

COUNTY KINGMAN

FIELD REIDA

**CONTACT PERSON KEN MORRISON PHONE 681-1623

PROD. FORMATION MISSISSIPPIAN

LEASE KALIVODA

PURCHASER UNKNOWN

WELL NO. #1

ADDRESS

WELL LOCATION C N/2 N/2 NE

DRILLING BEREDCO INC.

330' Ft. from NORTH Line and

CONTRACTOR

1320' Ft. from EAST Line of

ADDRESS 401 E. DOUGLAS, SUITE 402

the SEC. 19 TWP. 30S RGE. 6W


WICHITA, KS 67202

WELL FLAT

PLUGGING HALLIBURTON

CONTRACTOR

ADDRESS

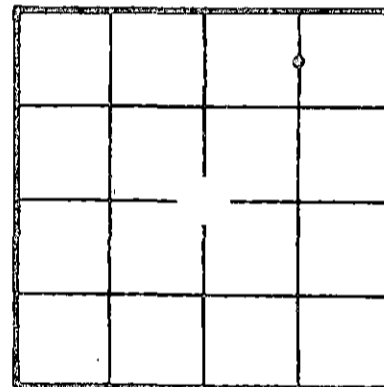

KCC [checked] KGS [checked] (Office Use)

TOTAL DEPTH 4680' PBTD 4633'

SPUD DATE 11-24-81 DATE COMPLETED 12-7-81

ELEV: GR 1439' DF KB 1451'

DRILLED WITH ROTARY TOOLS

Amount of surface pipe set and cemented 8 5/8" 24# @ 276'. DV Tool Used?

AFFIDAVIT

STATE OF KANSAS, COUNTY OF SEDGWICK SS, I,

ROD ANDERSEN OF LAWFUL AGE, BEING FIRST DULY SWORN UPON HIS OATH,

DEPOSES THAT HE IS A GEOLOGIST (FOR)(OF) PETRO-DYNAMICS, LTD.

OPERATOR OF THE KALIVODA LEASE, AND IS DULY AUTHORIZED TO MAKE

THIS AFFIDAVIT FOR AND ON THE BEHALF OF SAID OPERATOR, THAT WELL NO. #1 ON

SAID LEASE HAS BEEN COMPLETED AS OF THE 7th DAY OF DECEMBER, 19 81, AND THAT

ALL INFORMATION ENTERED HEREIN WITH RESPECT TO SAID WELL IS TRUE AND CORRECT.

FURTHER AFFIANT SAITH NOT.



SUBSCRIBED AND SWORN BEFORE ME THIS 18th DAY OF February, 19 81.

(S) Rodney E. Andersen

Jamie Jerome NOTARY PUBLIC

MY COMMISSION EXPIRES: November 1, 1985

**The person who can be reached by phone regarding any questions concerning this information. Within 45 days of completion, a witnessed initial test by the Commission is required if the well produces more than 25 BOPD or is located in a Basic Order Pool.