

STATE CORPORATION COMMISSION OF KANSAS
OIL & GAS CONSERVATION DIVISION
WELL COMPLETION OR RECOMPLETION FORM
ACO-1 WELL HISTORY
DESCRIPTION OF WELL AND LEASE

Amended

API NO. 15-129-20821-00-00
County Morton
SE NW NW Sec. 9 Twp 34 Rge 42 East X West

Operator: License # 6593
Name Coastal Oil & Gas Corporation
Address 211 N. Robinson, Suite 1700
Oklahoma City, Oklahoma 73102
City/State/Zip 73102

4446 Ft North from Southeast Corner of Section
4454 Ft West from Southeast Corner of Section
(Note: Locate well in section plat below)

Purchaser Gas: CIG
Oil: Derby

Lease Name Government Well # 2-9

Operator Contact Person C. Brad Crouch
Phone (405) 239-7031

Field Name Taloga North


Producing Formation Morrow

Contractor License # 5421
Name Sage Drilling Co.

Elevation: Ground 3423 KB 3435

Wellsite Geologist Richard Orsak
Phone (405) 239-7031

Section Plat

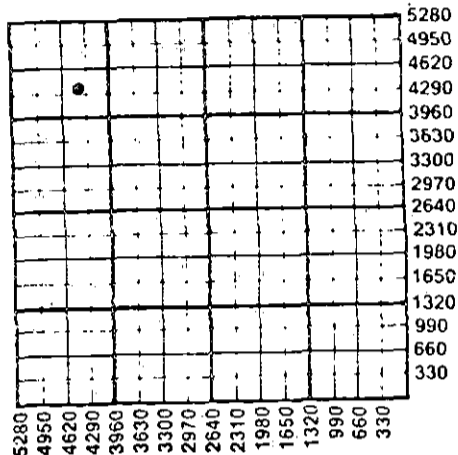

Designate Type of Completion
X New Well Re-Entry Workover
X Oil SWD Temp Abd
Gas Inj Delayed Comp.
Dry Other (Core, Water Supply etc.)

If ONWO: old well info as follows:
Operator
Well Name
Comp. Date Old Total Depth

WELL HISTORY

Drilling Method:
X Mud Rotary Air Rotary Cable
8-18-86 8-27-86 9-22-86
Spud Date Date Reached TD Completion Date
4660 4555
Total Depth PBTD

Amount of Surface Pipe Set and Cemented at 1327 feet
Multiple Stage Cementing Collar Used? Yes X No
If yes, show depth set feet
If alternate 2 completion, cement circulated
from 1327 feet depth to surface 765 SX cmt
Cement Company Name Western Co.
Invoice # 17975, 17976

WATER SUPPLY INFORMATION
Disposition of Produced Water: Disposal
Docket # Repressuring

Questions on this portion of the ACO-1 call:
Water Resources Board (913) 296-3717
Source of Water:
Division of Water Resources Permit # filed by contractor
Groundwater 4430 Ft North from Southeast Corner
(Well) 4354 Ft West from Southeast Corner of
Sec 9 Twp 34 Rge 42 East X West
Surface Water Ft North from Southeast Corner
(Stream, pond etc) Ft West from Southeast Corner
Sec Twp Rge East West
Other (explain)
(purchased from city, R.W.D. #)

INSTRUCTIONS: This form shall be completed in duplicate and filed with the Kansas Corporation Commission, 200 Colorado Derby Building, Wichita, Kansas 67202, within 90 days after completion or recompletion of any well. Rule 82-3-130 and 82-3-107 apply. Information on side two of this form will be held confidential for a period of 12 months if requested in writing and submitted with the form. See rule 82-3-107 for confidentiality in excess of 12 months. One copy of all wireline logs and drillers time log shall be attached with this form. Submit CP-4 form with all plugged wells. Submit CP-111 form with all temporarily abandoned wells.

All requirements of the statutes, rules and regulations promulgated to regulate the oil and gas industry have been fully complied with and the statements herein are complete and correct to the best of my knowledge.

Signature C. Brad Crouch
Title District Operations Superintendent Date 11-19-86

Subscribed and sworn to before me this 12th day of November 1986
Notary Public Diana Thompson
Date Commission Expires 11-18-88 12-5-1986

K.C.C. OFFICE USE ONLY
Letter of Confidentiality Attached
Wireline Log Received
Drillers Timelog Received
Distribution
KCC SWD/Rep NGPA
KGS Plug Other
(Specify)

DEC 5 1986

Sec 9 Twp 34 Rge 42