

STATE CORPORATION COMMISSION OF KANSAS  
OIL & GAS CONSERVATION DIVISION  
WELL COMPLETION OR RECOMPLETION FORM  
ACO-1 WELL HISTORY  
DESCRIPTION OF WELL AND LEASE

129-20821-00-00

API NO. 15-.....  
County.....Morton.....  
SE NW NW Sec. 9 Twp. 34 Rge. 42 East  
..... West

Operator: License # 6593  
Name Coastal Oil & Gas Corporation  
Address 211 N. Robinson, Suite 1700, One  
Leadership Sq., Okla. City, OK 73102  
City/State/Zip OKC, OK 73102

4446 ..... Ft North from Southeast Corner of Section  
4454 ..... Ft West from Southeast Corner of Section  
(Note: Locate well in section plat below)

Purchaser Gas: CIG  
Oil: Derby

Lease Name Government Well # 2-9

Operator Contact Person G. Brad Crouch  
Phone 239-7031 (405)

Field Name Greenwood Taloga, North


Producing Formation Morrow

Contractor License # 5421  
Name Sage Drilling Co.

Elevation: Ground 3423 3435 KB

Wellsite Geologist Richard Orsak  
Phone 239-7031 (405)

Section Plat

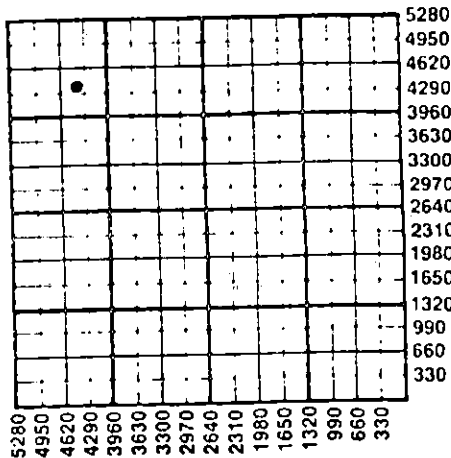

Designate Type of Completion  
 New Well  Re-Entry  Workover  
 Oil  SWD  Temp Abd  
 Gas  Inj  Delayed Comp.  
 Dry  Other (Core, Water Supply etc.)

If **OWNO**: old well Info as follows:  
Operator .....  
Well Name .....  
Comp. Date ..... Old Total Depth.....

WATER SUPPLY INFORMATION

Disposition of Produced Water:  Disposal  
Docket # .....  Repressuring

WELL HISTORY

Drilling Method:  Mud Rotary  Air Rotary  Cable  
8-18-86 8-27-86 9-22-86  
Spud Date Date Reached TD Completion Date  
4660 4555  
Total Depth PBTD

Questions on this portion of the ACO-1 call:  
Water Resources Board (913) 296-3717

Source of Water: filed by  
Division of Water Resources Permit #..... contractor

Amount of Surface Pipe Set and Cemented at 1327 feet  
Multiple Stage Cementing Collar Used?  Yes  No  
If yes, show depth set.....feet  
If alternate 2 completion, cement circulated  
from 1327 feet depth to surface/765 SX cmt  
Cement Company Name Western Co.  
Invoice # 17975, 17976

Groundwater 4430 Ft North from Southeast Corner  
(Well) 4354 Ft West from Southeast Corner of  
Sec 9 Twp 34 Rge 42 East  West

Surface Water.....Ft North from Southeast Corner  
(Stream, pond etc).....Ft West from Southeast Corner  
Sec Twp Rge East West

Other (explain).....  
(purchased from city, R.W.D. #)

INSTRUCTIONS: This form shall be completed in duplicate and filed with the Kansas Corporation Commission, 200 Colorado Derby Building, Wichita, Kansas 67202, within 90 days after completion or recompletion of any well. Rule 82-3-130 and 82-3-107 apply.  
Information on side two of this form will be held confidential for a period of 12 months if requested in writing and submitted with the form. See rule 82-3-107 for confidentiality in excess of 12 months. One copy of all wireline logs and drillers time log shall be attached with this form. Submit CP-4 form with all plugged wells. Submit CP-111 form with all temporarily abandoned wells.

All requirements of the statutes, rules and regulations promulgated to regulate the oil and gas industry have been fully complied with and the statements herein are complete and correct to the best of my knowledge.

Signature *G. Brad Crouch*  
Title District Operations Superintendent Date 9-23-86

K.C.C. OFFICE USE ONLY  
 Letter of Confidentiality Attached  
 Wireline Log Received  
 Drillers Timelog Received  
Distribution  
 KCC  SWD/Rep  NGPA  
 KGS  Plug  Other  
(Specify)

Subscribed and sworn to before me this 17th day of October 1986  
Notary Public *James Parker*  
Date Commission Expires 1-14-87

RECEIVED  
STATE CORPORATION COMMISSION  
CONS. DIV. WICHITA, KS

10-8-1986

OCT 8 1986

Sec 9 Twp 34 Rge 42