

Two (2) copies of this form shall be filed with the Kansas Corporation Commission, 200 Colorado Derby Building, Wichita, Kansas 67202, within thirty (30) days after the completion of a well, regardless of how the well was completed.

F Attach separate letter of request if the information is to be held confidential.
 If confidential, only file one copy. Information on Side One will be of public record and Side Two will then be held confidential.

Applications must be made on dual completion, commingling, salt water disposal, injection and temporarily abandoned wells.

C Attach one copy only wireline logs (i.e. electrical log, sonic log, gamma ray neutron log, etc.). (Rules 82-2-105 & 82-2-125) KCC# (316) 263-3238.

LICENSE # 5171 EXPIRATION DATE 6/30/83

OPERATOR TXO PROD. CORP. API NO. 15-095-21347-0000

ADDRESS 200 W. Douglas, Ste. 300 COUNTY Kingman

Wichita, KS 67202 FIELD Harding East

** CONTACT PERSON Harold R. Trapp PROD. FORMATION dry
 PHONE 265-9441

PURCHASER dry hole LEASE Depenbusch #3

ADDRESS dry hole WELL NO. #3

DRILLING Kandrilco, Rig #2 990 Ft. from North Line and

CONTRACTOR ADDRESS 555 N. Woodlawn, Bldg. 1, Ste. 207 1980 Ft. from West Line of

Wichita, KS 67208 the NW (Qtr.) SEC 32 TWP 29S RGE 10 (W).

PLUGGING Kandrilco WELL PLAT (Office Use Only)

CONTRACTOR ADDRESS 555 N. Woodlawn, Bldg. 1, Ste. 207

Wichita, Kansas 67208


TOTAL DEPTH 2750 PBTD none

SPUD DATE 6-9-83 DATE COMPLETED 6-13-83

ELEV: GR 1731 DF none KB 1736

DRILLED WITH ~~(CABLE)~~ (ROTARY) ~~(AKK)~~ TOOLS.

DOCKET NO. OF DISPOSAL OR REPRESSURING WELL BEING USED TO DISPOSE OF WATER FROM THIS LEASE DRY

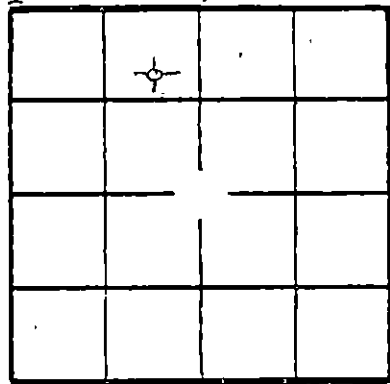

KCC
 KGS
 SWD/REP
 PLG.

Amount of surface pipe set and cemented 8-5/8" @ 254' DV Tool Used? no

THIS AFFIDAVIT APPLIES TO: (Circle ONE) - Oil, Gas, Shut-in Gas, Dry, Disposal, Injection, Temporarily Abandoned, OWWO. Other _____

ALL REQUIREMENTS OF THE STATUTES, RULES AND REGULATIONS PROMULGATED TO REGULATE THE OIL AND GAS INDUSTRY HAVE BEEN FULLY COMPLIED WITH.


A F F I D A V I T

I, Harold R. Trapp, being of lawful age, hereby certifies that:

I am the Affiant, and I am familiar with the contents of the foregoing Affidavit. The statements and allegations contained therein are true and correct.

Harold R. Trapp
 (Name)

SUBSCRIBED AND SWORN TO BEFORE ME this 16th day of June, 19 83.

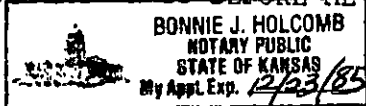

Bonnie J. Holcomb
 (NOTARY PUBLIC)

MY COMMISSION EXPIRES: 12-23-85

** The person who can be reached by phone regarding any questions concerning this information.

STATE CORPORATION COMMISSION

JUN 20 1983

CONSERVATION DIVISION
 Wichita, Kansas

6-20-83

SIDE TWO

OPERATOR TXO PROD. CORP.

LEASE Depenbusch

ACO-1 WELL HISTORY ~~(X)~~
 SEC. 32 TWP. 29S RGE. 10 (W)

FILL IN WELL INFORMATION AS REQUIRED:

WELL NO. #3

Shew all important zones of porosity and contents thereof; cased intervals, and all drill-stem tests, including depth interval tested, cushion used, time tool open, flowing and shut-in pressures, and recoveries.

SHOW GEOLOGICAL MARKERS, LOGS RUN, OR OTHER DESCRIPTIVE INFORMATION.

FORMATION DESCRIPTION, CONTENTS, ETC.	TOP	BOTTOM	NAME	DEPTH
XX Check if no Drill Stem Tests Run.			LOG TOPS	
			Herington	1839 -103
			Florence	2023 -287
			Foraker	2463 -727
			Onaga	2582 -846
			Indian Cave	2612 -876
			Waubunsee	2630 -894
			RTD	2750
			LTD	2754
			RAN O.H. LOGS	

If additional space is needed use Page 2, Side 2

Report of all strings set— surface, intermediate, production, etc. CASING RECORD (New) or (Use)

Purpose of string	Size hole drilled	Size casing set (in O.D.)	Weight lbs/ft.	Setting depth	Type cement	Secks	Type and percent additives
Surface	12½	8-5/8"	24#	254'	Class A	100	

LINER RECORD

PERFORATION RECORD

Top, ft.	Bottom, ft.	Secks cement	Shots per ft.	Size & type	Depth interval
none	none	none	none	none	none

TUBING RECORD

Size	Setting depth	Pecker set at
none	none	none

ACID, FRACTURE, SHOT, CEMENT SQUEEZE-RECORD

Amount and kind of material used	Depth interval treated
none	none

Date of first production D & A. 6-13-83	Producing method (flowing, pumping, gas lift, etc.) dry	Gravity none
Estimated Production -I.P. none	Gas none	Water % none
Disposition of gas (vented, used on lease or sold) dry hole	Perforations none	

Sun Oilwell Cementing
A Division of BJ Hughes, Inc.

P. O. Box 169
GREAT BEND, KANSAS 67530

CEMENTING TICKET
and Invoice Number

No. **14032**



















Sun Oilwell Cementing
 Division of BJ Hughes, Inc.

P. O. Box 169
GREAT BEND, KANSAS 67530

CEMENTING TICKET
 and Invoice Number

No. 14033

Date 6-13-62	Customer Order No.	Sec. 32	Twp. 27S	Range 16W	Truck Called Out 5:00 pm	On Location 1:15 pm	Job Began 8:25 pm	Job Completed 9:45 pm
Owner T.H.S.		Contractor Kearney Oil Co.			Charge To T.H.S.			
Mailing Address		City			State			
Well No. and Farm Dependent #3		Place St. Louis			County Lincoln		State Kansas	
Depth of Well 2750'	Depth of Job 650'	Casing New	Size 10 1/2"	Weight	Size of Hole Amt. and Kind of Cement 11.5 Sack	Cement Left in casing by	Request Necessity	
Kind of Job Plug to 650'					OW NW	Drillpipe 4 1/2"	Cable Rotary	Truck No. 2741
Condition of Well at time of Cementing Dry Hole					Type of Plug 1/4"			
Pressure Circulating		Minimum		Maximum				
Time Required, Mixing Cement		min.		Making Charge		min.		Pumping Cement

Remarks: Plug to 650' with 10.5 sacks Class A
 38A-7 2741 sec.
 25 SK @ 650'
 25 SK @ 525'
 25 SK @ 400' (Casing)
 10.5 SK in Casing (Casing)
 10.5 SK in New 1/4" Plug

Price Reference No. 9
Price of Job \$370.00
Second Stage
Standby Truck
Other Charges
Pump Truck Mileage \$33.00

Cement: Dave Whitson
 Helper: Steve Henty
 District: Medicine Lodge
 State: Kansas
 The above job was done under supervision of the owner, operator, or his agent whose signature appears below.
 State Plugger on Location: Yes No
 Signature: [Signature]
 Agent of Contractor or Operator

SALES TICKET FOR MATERIALS

QUANTITY SACKS	BRAND AND TYPE	PRICE	TOTAL
10.5	Class A	5.00/sack	525.00
RECEIVED STATE CORPORATION COMMISSION JUN 20 1962			
Rec'd: 17-7 296#	CONSERVATION DIVISION Wichita, Kansas	.22/sk	38.82
AM. Cl.			
Gel			
Plugs			
Delivered by Truck No.	Handling and Dumping 5.25/sk Mileage .25		1.31
Delivered From	Sales Tax		15.75
Signature of Operator	Total Charges		\$1,199.23