

This form shall be filed in duplicate with the Kansas Corporation Commission, 200 Colorado Derby Building, Wichita, Kansas 67202, within ten days after the completion of the well, regardless of how the well was completed.

Attach separate letter of request if the information is to be held confidential. If confidential, only file one copy. Information on side one will be of public record and side two will then be held confidential.

Circle one: Oil, Gas, Dry, SWD, OWWO, Injection. Type and complete ALL sections. Applications must be filed for dual completion, commingling, SWD and injection, T.A.

Attach wireline logs (i.e. electrical log, sonic log, gamma ray neutron log, etc.). KCC # (316) 263-3238. (Rules 82-2-105 & 82-2-125)

OPERATOR Pickrell Drilling Company

API NO. 15-095-21,217-00-00

ADDRESS 110 N. Market, Suite 205

COUNTY Kingman

Wichita, Kansas 67202

FIELD Wildcat

**CONTACT PERSON Jay McNeil

PROD. FORMATION N/A

PHONE 262-8427

LEASE Beck 'A'

PURCHASER

WELL NO. 1

ADDRESS

WELL LOCATION C SE SE

660 Ft. from South Line and

660 Ft. from East Line of

the SE/4 SEC. 10 TWP. 30S RGE. 6W

DRILLING Pickrell Drilling Company

CONTRACTOR

ADDRESS 110 N. Market, Suite 205

Wichita, Kansas 67202

PLUGGING Pickrell Drilling Company

CONTRACTOR

ADDRESS 110 N. Market, Suite 205

Wichita, Kansas 67202

TOTAL DEPTH 4500 PBTD N/A


SPUD DATE 1/19/82 DATE COMPLETED 1/30/82

ELEV: GR 1415 DF 1417 KB 1420

DRILLED WITH (CABLE) (ROTARY) (AIR) TOOLS

Amount of surface pipe set and cemented 3 5/8" @ 215' w/165SX DV Tool Used? No

WELL PLAT

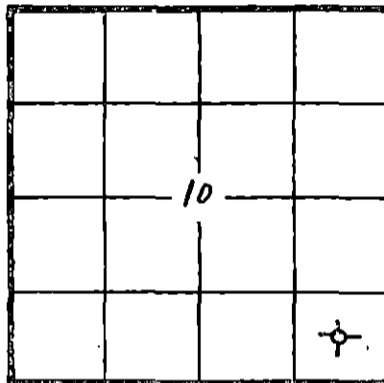

KCC KGS (Office Use)

AFFIDAVIT

STATE OF KANSAS, COUNTY OF Sedgwick SS, I,

C. W. Sebitts OF LAWFUL AGE, BEING FIRST DULY SWORN UPON HIS OATH,

DEPOSES THAT HE IS Attorney-In-Fact (FOR) Pickrell Drilling Company

OPERATOR OF THE Beck 'A' LEASE, AND IS DULY AUTHORIZED TO MAKE


THIS AFFIDAVIT FOR AND ON THE BEHALF OF SAID OPERATOR, THAT WELL NO. 1 ON

SAID LEASE HAS BEEN COMPLETED AS OF THE 30th DAY OF January, 19 82, AND THAT

ALL INFORMATION ENTERED HEREIN WITH RESPECT TO SAID WELL IS TRUE AND CORRECT.

FURTHER AFFIANT SAITH NOT.

Handwritten date: 2-8-82

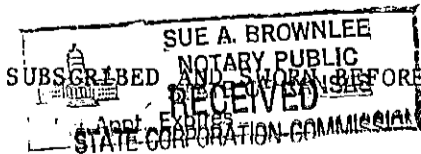

(S) C. W. Sebitts

C. W. Sebitts, 1982

Sue A. Brownlee NOTARY PUBLIC

MY COMMISSION EXPIRES February 24, 1985

**The person who can be reached by phone regarding any questions concerning this information. Within 45 days of completion, a witnessed initial test by the Commission is required if the well produces more than 25 BOPD or is located in a Basic Order Pool.

SIDE TWO

WELL LOG

Show all important zones of porosity and contents thereof; cored intervals, and all drill-stem tests, including depth interval tested, cushion used, time tool open, flowing and shut-in pressures, and recoveries.

SHOW GEOLOGICAL MARKERS, LOGS RUN, OR OTHER DESCRIPTIVE INFORMATION.

FORMATION DESCRIPTION, CONTENTS, ETC.	TOP	BOTTOM	NAME	DEPTH
DST #1: 1988-2012 (Indian Cave) 30"-60"-10"-out rec 30' mud IFP 47#-67# FFP 57#-57# ISIP 734# DST #2: 3685-3720 (Hertha) 30"-60"-60"-90" rec 1305' water IFP 174#-298# FFP 401#-586# ISIP 1400# FSIP 1400# DST #3: 4485-4500 (Simpson) 30"-60"-60"-90" rec 3660' SGCW IFP 789#-1268# FFP 1223#-1404# ISIP 1581# FSIP 1623#			KB Log Tops:	
			Heebner	2990
			Lansing	3242
			Kansas City	3512
			Mississippi	4092
			Kinderhook	4386
			Simpson	4497
			RTD	4500
			LTD	4500

Report of all strings set — surface, intermediate, production, etc. **CASING RECORD** (New) or (Used)

Purpose of string	Size hole drilled	Size casing set (in O.D.)	Weight lbs/ft.	Setting depth	Type cement	Sacks	Type and percent additives
Surface	12 3/4	8 5/8"	20#	215'	Common	165	Pozmix (3-2)

LINER RECORD

PERFORATION RECORD

Top, ft.	Bottom, ft.	Sacks cement	Shots per ft.	Size & type	Depth interval

TUBING RECORD

Size	Setting depth	Packer set at

ACID, FRACTURE, SHOT, CEMENT SQUEEZE RECORD

Amount and kind of material used	Depth interval treated

Date of first production	Producing method (flowing, pumping, gas lift, etc.)	Gravity
RATE OF PRODUCTION PER 24 HOURS	Oil bbls.	Gas MCF
	Water %	Gas-oil ratio bbls. CFPB
Disposition of gas (vented, used on lease or sold)		Perforations