

STATE OF KANSAS
STATE CORPORATION COMMISSION

Form CP-4


Give All Information Completely
Make Required Affidavit
Mail or Deliver Report to:
Conservation Division
State Corporation Commission
212 No. Market
Wichita, Kansas 67202

WELL PLUGGING RECORD

Kiowa County. Sec. 22 Twp. 29 Rge. (E) 18 (W)
Location as "NE/CNW/SW" or footage from lines C SW SW

Lease Owner Misco Supply Company
Lease Name Frank Yohn Well No. 1
Office Address 257 N. Broadway, Wichita, Kansas
Character of Well (completed as Oil, Gas or Dry Hole) oil
Date well completed _____ 19____
Application for plugging filed June 15 1971
Application for plugging approved _____ 19____
Plugging commenced July 6 1971
Plugging completed July 14 1971
Reason for abandonment of well or producing formation depleted

If a producing well is abandoned, date of last production _____ 19____
Was permission obtained from the Conservation Division or its agents before plugging was commenced? yes

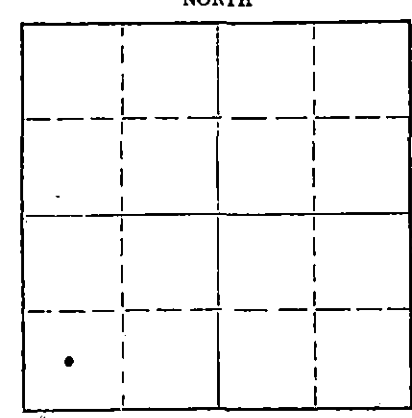

Locate well correctly on above Section Plat

Name of Conservation Agent who supervised plugging of this well G. R. Biberstein
Producing formation _____ Depth to top _____ Bottom _____ Total Depth of Well 5025 Feet
Show depth and thickness of all water, oil and gas formations.

OIL, GAS OR WATER RECORDS

CASING RECORD

FORMATION	CONTENT	FROM	TO	SIZE	PUT IN	PULLED OUT
		0	394'	10 3/4"	394'	none
		0	5004'	5 1/2"	5004'	3408.35

Describe in detail the manner in which the well was plugged, indicating where the mud fluid was placed and the method or methods used in introducing it into the hole. If cement or other plugs were used, state the character of same and depth placed, from _____ feet to _____ feet for each plug set.

Sanded back to 4900' and dumped 5 sacks of cement.

Set 20' rock bridge at 320'. Plugged well with 6 yards of ready mix cement.

RECEIVED
STATE CORPORATION COMMISSION
JUL 23 1971
CONSERVATION DIVISION
Wichita, Kansas

(If additional description is necessary, use BACK of this sheet)
Name of Plugging Contractor PIPE PULLERS, INC.
Address Box 486, Ellinwood, Kansas

STATE OF KANSAS, COUNTY OF BARTON, ss. Evelyn Roth

(employee of owner) or (owner or operator) of the above-described well, being first duly sworn on oath, says: That I have knowledge of the facts, statements, and matters herein contained and the log of the above-described well as filed and that the same are true and correct. So help me God.

(Signature) Evelyn Roth
Ellinwood, Kansas
(Address)

SUBSCRIBED AND SWORN TO before me this 20th day of July 1971

George A Meyer
Notary Public.

My commission expires Feb. 10, 1975

15-097-10140-0000

WELL LOG BUREAU—KANSAS GEOLOGICAL SOCIETY
503 East Murdock, Wichita, Kansas


COPY *R*

Company. OHIO OIL COMPANY
Farm. Frank Yohn No. 1

SEC. 22 T. 29 R. 18W
C SW SW

Total Depth. 5025
Comm. 12-17-56 Comp. 1-16-57
Shot or Treated.
Contractor. R. W. Rine Drilg Co.
Issued. 3-9-57

County Kiowa
KANSAS

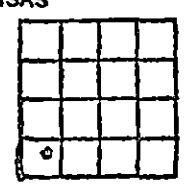

Elevation. 2191 KB

Production. 102 BO, 505,000 cu.ft. gas & 17 BW in 24 hrs. flowing.

Figures indicate Bottom of Formations.

shale, sand & rock	765
shale, red bed	1047
shale, sand	1469
shale, shells	2259
lime, shale, shells	2360
lime, shale	2645
lime	2762
lime, shale	2922
lime	2990
lime, shale	3003
lime	3049
lime, shale	3308
lime	3440
lime, shale	3591
lime	3675
lime, shale	3953
lime	4150
lime, shale	4316
lime	4410
lime, shale	4463
lime	4680
lime, chert	4765
lime	4800
lime, chert	5025
Total Depth	

Tops:

Heebner shale	4085
Brown lime	4258
Kansas City lime	4270
Mississippi chert	4872
Mississippi lime	4955

Perforated: 4930-4957.
Treatment: 400 gallons mud acid.

RECEIVED
STATE CORPORATION COMMISSION
JUN 17 1971
CONSERVATION DIVISION
Wichita, Kansas