

STATE OF KANSAS
STATE CORPORATION COMMISSION

Give All Information Completely
Make Required Affidavit
Mail or Deliver Report to:
Conservation Division
State Corporation Commission
211 No. Broadway
Wichita, Kansas

WELL PLUGGING RECORD

Kiowa County, Sec. 26 Twp. 29 Rge. 18 (E) W (W)

Location as "NE/CNWxSWx" or footage from lines C SW SW

Lease Owner Kenneth Rupp

Lease Name Parkin Well No. 1

Office Address 427 Union Center, Wichita, Kansas

Character of Well (completed as Oil, Gas or Dry Hole) D & A

Date well completed May 10 1961

Application for plugging filed May 10 1961

Application for plugging approved May 10 1961


Plugging commenced May 10 1961

Plugging completed May 10 1961

Reason for abandonment of well or producing formation D & A

If a producing well is abandoned, date of last production _____ 19____

Was permission obtained from the Conservation Division or its agents before plugging was commenced? Yes

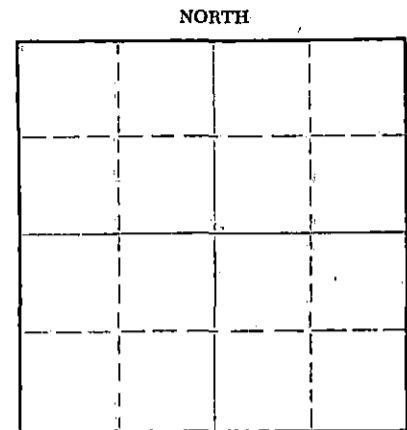

Locate well correctly on above Section Plat

Name of Conservation Agent who supervised plugging of this well W. L. Lackamp

Producing formation _____ Depth to top _____ Bottom _____ Total Depth of Well _____ Feet

Show depth and thickness of all water, oil and gas formations.

OIL, GAS OR WATER RECORDS

CASING RECORD

FORMATION	CONTENT	FROM	TO	SIZE	PUT IN	PULLED OUT
				8 5/8"	309*	-0-

Describe in detail the manner in which the well was plugged, indicating where the mud fluid was placed and the method or methods used in introducing it into the hole. If cement or other plugs were used, state the character of same and depth placed, from _____ feet to _____ feet for each plug set.

Filled hole with heavy mud to 300*. Set bottom plug with 20 sx cement. Filled with mud to 35* and set top plug with 10 sx cement. Put 2 sx cement in rat hole.

RECEIVED
STATE CORPORATION COMMISSION

MAY 19 1961
5-19-1961
CONSERVATION DIVISION
Wichita, Kansas

(If additional description is necessary, use BACK of this sheet)

Name of Plugging Contractor Red Tiger Drilling Company

Address Box 173, Russell, Kansas

STATE OF KANSAS, COUNTY OF SEDGWICK, ss. George A. Angle (employee of owner) or (owner or operator) of the above-described well, being first duly sworn on oath, says: That I have knowledge of the facts, statements, and matters herein contained and the log of the above-described well as filed and that the same are true and correct. So help me God.

(Signature) George A. Angle

580 Fourth Nat'l Bank Bldg., Wichita, Ks.
(Address)

Subscribed and sworn to before me this 12th day of May, 1961

My commission expires 11-17-62
Maguire Head
Notary Public.



DRILLERS LOG

No. 1 Parkin

CASING RECORD: 8 5/8" @ 309' w/175 sx cement
 COMPANY: Kenneth Rupp
 CONTRACTOR: Red Tiger Drilling Co.
 COMMENCED: April 25, 1961
 COMPLETED: May 10, 1961

DESCRIPTION: C SW SW
 26-298-18W
 Nowa County
 Kansas
 ELEVATION: 2156 DF
 2159 RB

TOTAL DEPTH: 4970'

<u>FORMATION</u>	<u>FROM</u>	<u>TO</u>	<u>REMARKS</u>
Clay & Sand Streak	0	90	
Sand & Shale	90	115	
Shale	115	295	
Sand	295	305	
Shale	305	314	
Red Bed	314	1078	
Anhydrite	1078	1102	
Red Bed	1102	1280	
Blue Shale	1280	1400	RECEIVED STATE CORPORATION COMMISSION
Shale & Shells	1400	2090	MAY 19 1961
Shale Lime	2090	2325	
Shale & Chalk Lime	2325	2425	CONSERVATION DIVISION Wichita, Kansas
Lime & Shale	2425	4355	
Lime	4355	4566	
Hard Sharp Lime	4566	4577	
Lime	4577	4654	
Lime & Shale	4654	4728	
Lime	4728	4760	
Lime & Shale	4760	4856	
Lime	4856	4905	
Mississippi Lime	4905	4970	

Log Total Depth 4967'

I certify that this is a true and correct copy of the above log to the best of my knowledge.

RED TIGER DRILLING COMPANY

George A. Angle

 George A. Angle

Subscribed and sworn to before me this 12th day of May, 1961.

Madeline Head

 Notary Public

My Commission Expires:

11-17-62

