


STATE OF KANSAS
STATE CORPORATION COMMISSION

WELL PLUGGING RECORD

Give All Information Completely
Make Required Affidavit
Mail or Deliver Report to
Conservation Division
State Corporation Comm.
245 North Water
Wichita, KS 67202

Kiowa County, Sec. 7 Twp. 29S Rge. 19 ~~W~~
Location as "NE/CNW 1/4 SW 1/4" or footage from lines
C NE NE
Lease Owner D N B Drilling, Inc.
Lease Name Fralick Well No. 1
Office Address 515 R.H. Garvey Bldg., Wichita, Ks. 67202
Character of Well (Completed as Oil, Gas or Dry Hole)
dry hole
Date Well completed 1-23 1979
Application for plugging filed 1-23 1979
Application for plugging approved 1-23 1979
Plugging commenced 1-23 1979
Plugging completed 1-23 1979
Reason for abandonment of well or producing formation
no commercial quantities of oil or gas encountered
If a producing well is abandoned, date of last production
19

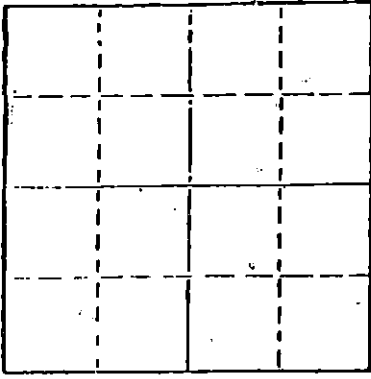

Locate well correctly on above
Section Plot

Was permission obtained from the Conservation Division or
its agents before plugging was commenced? yes

Name of Conservation Agent who supervised plugging of this well Bill Owen
Producing formation _____ Depth to top _____ Bottom _____ Total Depth of Well 5118
Show depth and thickness of all water, oil and gas formations.

OIL, GAS OR WATER RECORDS

CASING RECORD

FORMATION	CONTENT	FROM	TO	SIZE	PUT IN	PULLED OUT
surface hole	shale	surf	623'	8-5/8"	616	none

Describe in detail the manner in which the well was plugged, indicating where the mud fluid
was placed and the method or methods used in introducing it into the hold. If cement or other
plugs were used, state the character of same and depth placed, from _____ feet to
_____ feet for each plug set.

Fluid to 600', plug, 50 sx
Fluid to 40', plug, 12 sx
3 sx in rat hole

RECEIVED
STATE CORPORATION COMMISSION

FEB - 2 1979

2-2-1979
CONSERVATION DIVISION
Wichita, Kansas

(If additional description is necessary, use BACK of this sheet)

Name of Plugging Contractor D N B DRILLING, INC.
515 R. H. Garvey Building
Wichita, Kansas 67202

STATE OF Kansas COUNTY OF Sedgwick, ss.
Ella Priess (employee of owner) or (owner or operator)
of the above-described well, being first duly sworn on oath, says: That I have knowledge of
the facts, statements, and matters herein contained and the log of the above-described well
as filed and that the same are true and correct. So help me God.

(Signature) Ella Priess
Suite 515 R.H. Garvey Bldg., Wichita, Ks.
(Address) 67202

SUBSCRIBED AND SWORN TO before me this 30th day of January, 1979

My commission expires April 30, 1979

Dorothy L. Schmidt
Dorothy L. Schmidt Notary Public.

DOROTHY L. SCHMIDT
STATE NOTARY PUBLIC
Sedgwick County, Kansas
My Appt. Exp. April 30, 1979

DRILLER'S LOG

D N B DRILLING, INC.
No. 1 Fralick
C NE NE Sec. 7-29S-19W
Kiowa Co., Ks.

Elevation: GL 2356

Commenced: 1-11-79
Completed: 1-23-79

Surface Casing: 616' of 8-5/8"
cemented w/450 sx common, 2% gel, 3% cc
1-11-79

FORMATION

DEPTH

Surface Hole	0 - 623
Shale	623 - 650
Sand & Lime	650 - 1251
Shale & Lime	1251 - 2440
Lime & Shale	2440 - 2870
Shale & Lime	2870 - 3029
Shale	3029 - 3194
Shale & Lime	3194 - 4040
Shale	4040 - 4197
Lime & Shale	4197 - 4480
Shale	4480 - 4630
Lime	4630 - 4850
Shale	4850 - 4953
Lime	4953 - 5118 RTD

I do hereby certify that the foregoing statements are true and correct to the best of my knowledge and belief.

D N B DRILLING, INC.

Ella Priess
Ella Priess

STATE OF KANSAS: ss:

Subscribed and sworn to before me this 30th day of January, 1979.

Dorothy L. Schmidt
Dorothy L. Schmidt, Notary Public

RECEIVED
STATE COOPERATION COMMISSION

FEB - 2 1979

CONSERVATION DIVISION
Wichita, Kansas

DOROTHY L. SCHMIDT
STATE NOTARY PUBLIC
Sedgwick County, Kansas
My Appt. Exp. April 30, 1979