

WELL PLUGGING RECORD

All Information Completely
 Required Affidavit
 or Deliver Report to
 Conservation Division
 State Corporation Comm.
 245 North Water
 Wichita, KS 67202

Kiowa County, Sec. 4 Twp. 29S Rge. 19 E/W
 Location as "NE/CNW 1/4 SW 1/4" or footage from lines


Lease Owner Cinco Exploration Company
 Lease Name Weta K. Smith Well No. 1
 Office Address P.O. Box 3723 Victoria, TX 77901
 Character of Well (Completed as Oil, Gas or Dry Hole)
 Dry hole

Date Well completed 10-16 1982
 Application for plugging filed 10-16 1982
 Application for plugging approved 10-16 1982
 Plugging commenced 10-16 1982
 Plugging completed 10-16 1982
 Reason for abandonment of well or producing formation
 Dry hole

If a producing well is abandoned, date of last production 19

Was permission obtained from the Conservation Division or
 its agents before plugging was commenced? Yes

Name of Conservation Agent who supervised plugging of this well Steve Durrant
 Producing formation Depth to top Bottom Total Depth of Well
 No depth and thickness of all water, oil and gas formations.

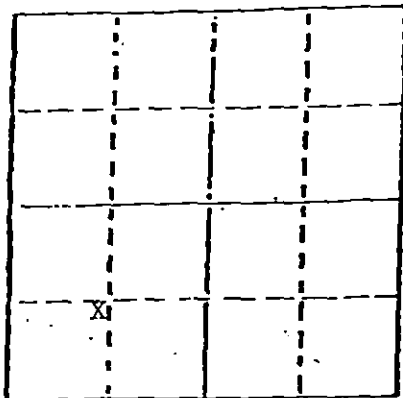

OIL, GAS OR WATER RECORDS

CASING RECORD

FORMATION	CONTENT	FROM	TO	SIZE	PUT IN	PULLED OUT
				436	8 5/8	

Describe in detail the manner in which the well was plugged, indicating where the mud fluid
 placed and the method or methods used in introducing it into the hold. If cement or other
 materials were used, state the character of same and depth placed, from feet to
 feet for each plug set.

- 70 sks @ 1,020'
- 40 sks @ 450'
- 10 sks @ 40'
- 10 sks in Rat Hole
- 10 sks in Mouns Hole
- 10 sks in Water Well

(If additional description is necessary, use BACK of this sheet)

Name of Plugging Contractor Eagle Drilling, Inc.

STATE OF Kansas COUNTY OF Sedgwick, ss.
 John Miles (employee of owner) or (owner or operator)

I, the above-described well, being first duly sworn on oath, says: That I have knowledge of
 the facts, statements, and matters herein contained and the log of the above-described well
 filed and that the same are true and correct. So help me God.

(Signature) John Miles
 P.O. Box 8609 (Wichita, Kansas 67208)
 (Address)

SUBSCRIBED AND SWORN TO before me this 21st day of October, 1982

MAUREEN E. GILE
 STATE NOTARY PUBLIC
 Sedgwick County, Kansas
 My Appl. Exp. 9/28/83

Maureen E. Gile
 Notary Public.

RECEIVED
 STATE CORPORATION COMMISSION
 OCT 22 1982
 CONSERVATION DIVISION
 Wichita Kansas

DRILLER'S LOG

Operator: Cinco Exploration Company
Well Name: Weta K. Smith #1
Well Location: _____
Sec. 4 T29S R19W
County, State: Kiowa Kansas

Commenced: 10-7-82
Completed: 10-16-82

Surface Casing: 436' 8 5/8 used 24 lbs.
Cemented 200 sks light 3%cc, 100 common 2%gel
3%cc

<u>FORMATION</u>	<u>DEPTH</u>
<u>Sand</u>	<u>0-205</u>
<u>Blue Shale</u>	<u>205-436</u>
<u>Blue Shale Antihydrite</u>	<u>436-1711</u>
<u>Shale & shells</u>	<u>1711-2166</u>
<u>Shale & lime</u>	<u>2166-2420</u>
<u>Shale, lime & chert</u>	<u>2420-2470</u>
<u>Shale & lime</u>	<u>2470-4837</u>
<u>Lime</u>	<u>4837-4900</u>
<u>Shale & lime</u>	<u>4900-5015</u>
<u>Lime</u>	<u>5015-5045</u>
<u>Shale & lime</u>	<u>5045-5155</u>
<u>Lime</u>	<u>5155-5208</u>
<u>T.D.</u>	<u>5208'</u>


I do hereby certify that the foregoing statements are true and correct to the best of my knowledge and belief.

EAGLE DRILLING, INC.

John Miles
John Miles
Controller

STATE OF KANSAS)
COUNTY OF SEDGWICK) ss:

Subscribed and sworn to before me this 21st day of October, 1982

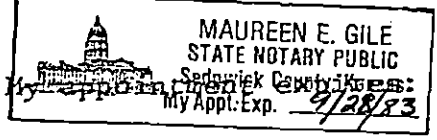
MAUREEN E. GILE
STATE NOTARY PUBLIC
Sedgewick County, Kansas
My App. Exp. 9/28/83

Maureen E. Gile
Notary Public