

15-097-10240-0000


STATE OF KANSAS
STATE CORPORATION COMMISSION

WELL PLUGGING RECORD

Give All Information Completely
Make Required Affidavit
Mail or Deliver Report to:
Conservation Division
State Corporation Commission
211 No. Broadway
Wichita, Kansas

Kiowa County. Sec. 1 Twp 29S. Rge. 19 (E) (W)
Location as "NE/CNW%SW%" or footage from lines NW NW NW
Lease Owner E. H. ADAIR OIL COMPANY
Lease Name COLLINGWOOD Well No. 1.
Office Address 1017 EAST SECOND STREET, WICHITA 7, KANSAS.
Character of Well (completed as Oil, Gas or Dry Hole) Dry-hole.
Date well completed 3/1 19 56
Application for plugging filed 3/1 19 56
Application for plugging approved 3/1 19 56
Plugging commenced 3/1 19 56
Plugging completed 3/1 19 56
Reason for abandonment of well or producing formation Dry-hole.

NORTH

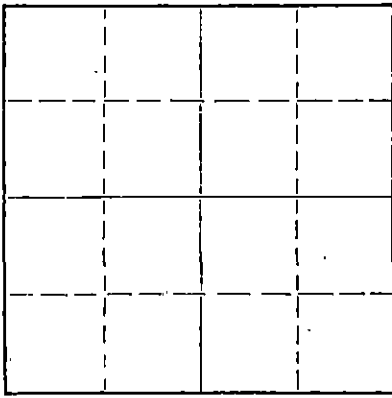

Locate well correctly on above
Section Plat

If a producing well is abandoned, date of last production _____ 19____
Was permission obtained from the Conservation Division or its agents before plugging was commenced? Yes.

Name of Conservation Agent who supervised plugging of this well Mr. M. A. Rives, Box No. 8, Pratt, Kansas.
Producing formation _____ Depth to top _____ Bottom _____ Total Depth of Well 5570 Feet
Show depth and thickness of all water, oil and gas formations.

OIL, GAS OR WATER RECORDS

CASING RECORD

FORMATION	CONTENT	FROM	TO	SIZE	PUT IN	PULLED OUT
(COPY OF DRILLER'S LOG ATTACHED HERETO)						

Describe in detail the manner in which the well was plugged, indicating where the mud fluid was placed and the method or methods used in introducing it into the hole. If cement or other plugs were used, state the character of same and depth placed, from _____ feet to _____ feet for each plug set.

Placed plug at 290 feet; 20 sacks cement on plug through drill-pipe.
Filled hole with mud up to 35 ft. Placed plug. Put 10 sacks on
plug. Filled hole to surface.

(If additional description is necessary, use BACK of this sheet)

Name of Plugging Contractor E. H. ADAIR OIL COMPANY
Address 1017 EAST SECOND STREET, WICHITA 7, KANSAS.

STATE OF KANSAS, COUNTY OF SEDGWICK, ss.
K. W. JOHNSON (employee of owner) or (owner or operator) of the above-described well, being first duly sworn on oath, says: That I have knowledge of the facts, statements, and matters herein contained and the log of the above-described well as filed and that the same are true and correct. So help me God.

(Signature) [Signature]
1017 East Second Street, Wichita 7, Kansas. K. W. Johnson (Address)


SUBSCRIBED AND SWORN TO before me this 5th day of March, 19 56

My commission expires Sept. 15, 1957.

[Signature]
Notary Public.

MAR 8 1956 3-8-1956

CONSERVATION DIVISION
- Kansas

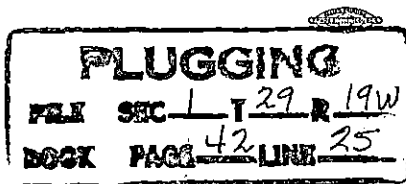

E. H. ADAIR OIL COMPANY
WICHITA 7, KANSAS.

E. H. Adair Oil Company
Collingwood No. 1
NW NW NW of
Sec. 1 - Twp. 29 S., R. 19 W.
Kiowa County, Kansas

Comm. 1-28-56
Comp. 3-1-56
Contractor:
Adair - Rig No. 1.
8-5/8 @ 295 ft. w/ 280 sx.

Elev. 2319 K.B.

Figures indicate tops of Formations.

Shale	to	110	Lime	to	4723
Sand		150	Shale		4726
Red shale		295	Lime		4740
Shale & shells		635	Shale		4744
Lime		660	Lime		4772
Shale		1477	Shale		4777
Shale & redbuds		1822	Lime		4784
Shale & shells		2366	Shale & lime		4803
Shale & lime		3265	Shale		4812
Shale		3625	Lime		4816
Shale & lime		3670	Shale		4824
Shale		3820	Cherty lime		4851
Shale & lime		4000	Shale		4860
Lime		4134	Lime		4874
Shale, black		4139	Shale		4891
Lime, shaley		4179	Lime		4901
Black shale		4184	Shale		4907
Lime		4187	Lime		4929
Black shale		4192	Shale		4934
Lime		4195	Lime		4949
Shale		4203	Shale		4955
Lime & shaley			Shaley lime		4968
lime		4222	Chert & shale		4974
Shale		4350	Chert		5008
Lime		4354	Cherty lime		5133
Shale		4359	Shale		5139
Lime		4406	Cherty dolomitic		
Shale		4416	lime		5210
Lime		4451	Shale, sand &		
Shale		4456	dolomite		5244
Lime		4471	Cherty dolomite		
Shale		4474	& cherty lime		5400
Lime		4515	Lime		5445
Shale		4518	Shale		5448
Lime		4532	Sandy dolomite		5529
Shale		4537	Sandy & shaley		
Lime		4549	dolomite		5550
Shale		4552	Dolomitic Sand		5558
Lime		4617	Dolomite		5570
Shale		4621			
Lime		4669			
Shale		4676			

STANDARD OIL COMPANY
WICHITA DIVISION

MAR 8 1956

CONSERVATION DIVISION
Wichita, Kansas

PLUGGING
FILE SEC 1 T 29 R 19 W
BOOK PAGE 42 LINE 25

E. H. Adair Oil Company - Collingwood No. 1.
NW NW NW of Sec. 1-29S.-19W., Kiowa County, Kansas.

Geological Tops

HEEBNER	4174 (-1855)
DOUGLAS	4218 (-1899)
BR. LIME	4346 (-2027)
LANSING	4360 (-2041)
MARMATON	4774 (-2455)
MISSISSIPPI	4972 (-2653)
KINDERHOOK	5210 (-2891)
VIOLA	5244 (-2925)
SIMPSON	5445 (-3126)
ARBUCKLE	5557 (-3238)
Total Depth	5570 (-3251)

Certified correct:

K. W. Johnson
K. W. Johnson Geologist.

