

STATE OF KANSAS  
STATE CORPORATION COMMISSION

Form CP-4

Give All Information Completely  
Make Required Affidavit  
Mail or Deliver Report to:  
Conservation Division  
State Corporation Commission  
212 No. Market  
Wichita, Kansas

WELL PLUGGING RECORD

Kiowa County, Sec. 1 Twp. 29 Rge. 20 (E) (W)

Location as "NE/CNW/SW" or footage from lines C NW NW

Lease Owner Mull Drilling Company, Inc.

Lease Name Alford Well No. A-1

Office Address 1625 Wichita Plaza Building Wichita, Kansas 67210

Character of Well (completed as Oil, Gas or Dry Hole) \_\_\_\_\_

Date well completed \_\_\_\_\_ 19 \_\_\_\_\_

Application for plugging filed 9-23-66 19 \_\_\_\_\_

Application for plugging approved 9-24-66 19 \_\_\_\_\_


Plugging commenced 9-27-66 19 \_\_\_\_\_

Plugging completed 10-12-66 19 \_\_\_\_\_

Reason for abandonment of well or producing formation \_\_\_\_\_

If a producing well is abandoned, date of last production \_\_\_\_\_ 19 \_\_\_\_\_

Was permission obtained from the Conservation Division or its agents before plugging was commenced? Yes

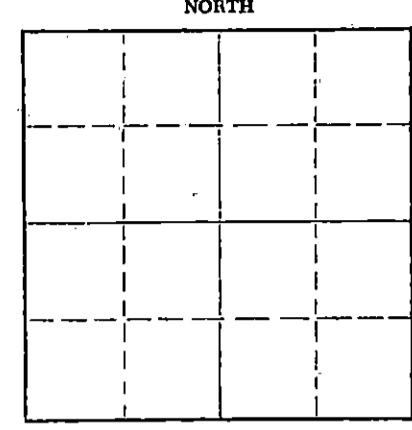

Name of Conservation Agent who supervised plugging of this well Archie V. Elving

Producing formation \_\_\_\_\_ Depth to top \_\_\_\_\_ Bottom \_\_\_\_\_ Total Depth of Well PB 5032 Feet

Show depth and thickness of all water, oil and gas formations.

OIL, GAS OR WATER RECORDS

CASING RECORD

FORMATION	CONTENT	FROM	TO	SIZE	PUT IN	PULLED OUT
				8 5/8	142	None
				4 1/2	None	3037

RECEIVED  
STATE CORPORATION COMMISSION  
OCT 19 1966  
CONSERVATION DIVISION  
Wichita, Kansas

Describe in detail the manner in which the well was plugged, indicating where the mud fluid was placed and the method or methods used in introducing it into the hole. If cement or other plugs were used, state the character of same and depth placed, from \_\_\_\_\_ feet to \_\_\_\_\_ feet for each plug set.

Moved in. Cleaned out cellar.

Sanded to 4800'. Dumped 3 sacks of cement. Working pipe. Shot pipe at 4400' & 4320'.

Working pipe. Circulating. Spotted 70 bbl of oil by Globe Oilwell Cementing, Inc.

Working pipe.

Working pipe.

Working pipe. Shot pipe at 4000' - 3800' - 3600' - 3500' - 3300' - 3200' - 3100' and 3030'. Pulling pipe.

Pulling pipe. Plugging well. Set rock bridge at 340'. Dumped 27 sacks of cement. Filled hole and rock bridge. Capped well with 10 sacks of cement. Cleaned and doped collar threads.

(If additional description is necessary, use BACK of this sheet)

Name of Plugging Contractor Forbes Casing Pulling, Inc.  
Address P. O. Box 221 Great Bend, Kansas

STATE OF Kansas, COUNTY OF Barton, ss. J. O. Forbes (employee of owner) or (owner or operator) of the above-described well, being first duly sworn on oath, says: That I have knowledge of the facts, statements, and matters herein contained and the log of the above-described well as filed and that the same are true and correct. So help me God.

(Signature) J. O. Forbes  
P. O. Box 221 Great Bend, Kansas  
(Address)

SUBSCRIBED AND SWORN TO before me this 17 day of October, 1966

My commission expires May 27, 1969 Notary Public.