

STATE OF KANSAS  
STATE CORPORATION COMMISSION


RECEIVED  
STATE CORPORATION COMMISSION  
9-30-1981  
SEP 30 1981  
CONSERVATION DIVISION  
Wichita, Kansas

WELL PLUGGING RECORD

Give All Information Completely  
Make Required Affidavit  
Mail or Deliver Report to  
Conservation Division  
State Corporation Comm.  
245 North Water  
Wichita, KS 67202

Kiowa County, Sec. 16 Twp. 29S Rge. 20W E/W  
Location as "NE/CNW $\frac{1}{4}$ SW $\frac{1}{4}$ " or footage from lines  
C NW

Lease Owner Midco Exploration, Inc.  
Lease Name Birney Well No. 1  
Office Address 2625 Butterfield Road, Oakbrook, IL 60521  
Character of Well (Completed as Oil, Gas or Dry Hole)

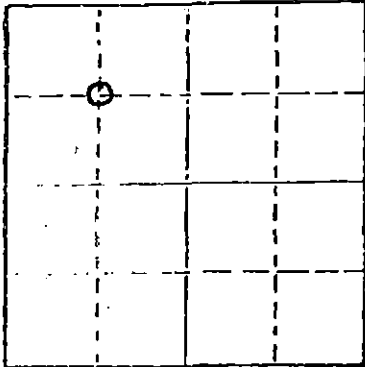

Locate well correctly on above  
Section Plot

Date Well completed September 23, 1981  
Application for plugging filed September 23, 1981  
Application for plugging approved September 23, 1981  
Plugging commenced 5:00 p.m. 19    
Plugging completed 5:30 p.m. 19  

Reason for abandonment of well or producing formation  
D & A  
If a producing well is abandoned, date of last production  
none 19  

Was permission obtained from the Conservation Division or  
its agents before plugging was commenced? yes

Name of Conservation Agent who supervised plugging of this well Maurice V. Leslie  
Producing formation None Depth to top X Bottom X Total Depth of Well 5252'  
Show depth and thickness of all water, oil and gas formations.

OIL, GAS OR WATER RECORDS

CASING RECORD

FORMATION	CONTENT	FROM	TO	SIZE	PUT IN	PULLED OUT
				8 5/8"	616	none

Describe in detail the manner in which the well was plugged, indicating where the mud fluid was placed and the method or methods used in introducing it into the hold. If cement or other plugs were used, state the character of same and depth placed, from    feet to    feet for each plug set.

Run hole full of mud. 50 sacks at 1750  
35 sacks at 600' on plug  
10 sacks at 40' Bridge Plug  
5 sacks Rat Hole  
5 sacks Mouse Hole

(If additional description is necessary, use BACK of this sheet)

Name of Plugging Contractor State Corporation Commission of Kansas

STATE OF KANSAS COUNTY OF SEDGWICK, ss.  
Phyllis Buchanan (employee of owner) or (owner or operator)  
of the above-described well, being first duly sworn on oath, says: That I have knowledge of the facts, statements, and matters herein contained and the log of the above-described well as filed and that the same are true and correct. So help me God.

(Signature) Phyllis Buchanan  
PHYLLIS BUCHANAN

SUBSCRIBED AND SWORN TO before me this 28th day of September, 19 81

My commission expires     
Sherry Myers Notary Public.  
SHERRY MYERS

