


STATE OF KANSAS  
STATE CORPORATION COMMISSION

Form CP-4

Give All Information Completely  
Make Required Affidavit  
Mail or Deliver Report to:  
Conservation Division  
State Corporation Commission  
P. O. Box 17027  
Wichita, Kansas 67217  
NORTH

WELL PLUGGING RECORD

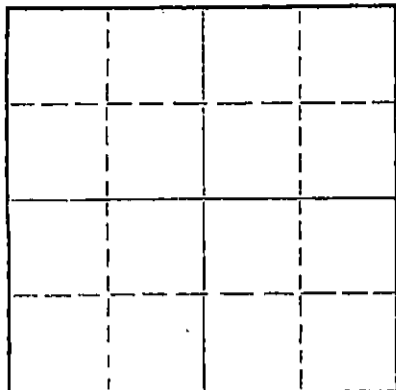

Locate well correctly on above  
Section Plat

Kiowa County, Sec. 33 Twp. 29 Rge. 18 (E) (W)  
Location as "NE/CNWxSWx" or footage from lines: C of SW - NW  
Lease Owner: Misco Industries, Inc.  
Lease Name: K. Brown Well No. 5  
Office Address: Wichita, Kansas  
Character of Well (completed as Oil, Gas or Dry Hole)  
Date well completed: 19  
Application for plugging filed: 19  
Application for plugging approved: 19  
Plugging commenced: 6-3-1972  
Plugging completed: 6-8-1972  
Reason for abandonment of well or producing formation

If a producing well is abandoned, date of last production: 19  
Was permission obtained from the Conservation Division or its agents before plugging was commenced? Yes

Name of Conservation Agent who supervised plugging of this well: G. R. Biberstein  
Producing formation: Depth to top: Bottom: Total Depth of Well: 5010 Feet  
Show depth and thickness of all water, oil and gas formations.

OIL, GAS OR WATER RECORDS

CASING RECORD

FORMATION	CONTENT	FROM	TO	SIZE	PUT IN	PULLED OUT
				8 3/8	404	None
				5 1/2	5009	3475

Describe in detail the manner in which the well was plugged, indicating where the mud fluid was placed and the method or methods used in introducing it into the hole. If cement or other plugs were used, state the character of same and depth placed, from \_\_\_\_\_ feet to \_\_\_\_\_ feet for each plug set.

Plug @ 4500 ft. - sand to 4450 - dump 5 sax cement.  
Pull 3475 ft. 5 1/2" pipe - plug @ 220 ft. - rock bridge to 210 ft.  
Dump 3 yds ready mix cement to surface.


RECEIVED  
STATE CORPORATION COMMISSION  
JUL 19 1972  
CONSERVATION DIVISION  
Wichita, Kansas  
7-19-1972

(If additional description is necessary, use BACK of this sheet)  
Name of Plugging Contractor: Ralph Comstock Pipe Pulling, Inc. Permit # 490  
Address: Stafford, Kansas

STATE OF Kansas COUNTY OF Sedgwick, ss.  
Thomas R. Sprouel (employee of owner) or (owner or operator) of the above-described well, being first duly sworn on oath, says: That I have knowledge of the facts, statements, and matters herein contained and the log of the above-described well as filed and that the same are true and correct. So help me God.

(Signature) Thomas R. Sprouel  
(Address)

Subscribed and sworn to before me this 17th day of July, 1972

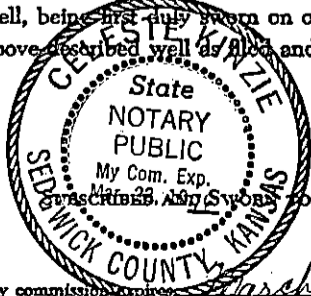

My commission expires March 23, 1976

Celeste Kinzie  
Notary Public.

15-092-10031-0000  
 WELL LOG BUREAU--KANSAS GEOLOGICAL SOCIETY  
 508 East Murdock, Wichita, Kansas

COPY

Company- THEODORE GORE  
 Farm- Keith Brown

No. 5

SEC. 33 T. 29 R. 18W  
 C SW NW

Total Depth. 5010'

Comm. 7-6-58

Shot or Treated.


Contractor. Armer, Inc.

Issued. 10-18-58

Comp. 7-30-58

County Kiowa

KANSAS

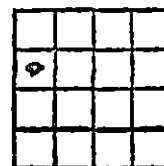

Elevation. 2199' DE

Production. 240 BOPD

CASING:

8" 404'  
 5" 5009'

Figures indicate Bottom of Formations.

clay, sand, shale	160
shale, shells, red bed	405
red bed, sand, shale,	
shells	770
red bed	955
red bed, shale, shells	1550
salt, shells, shale,	
red bed	1855
shale, shells, lime stks	
	2125
shale, lime	2365
lime	2450
lime, shale	2540
lime	2690
lime, shale	3645
lime	3715
lime, shale	3910
lime	4023
lime, shale	4320
lime	4525
lime, chert	4550
lime	4713
lime, shale	4798
lime	4816
lime, shale	4940
chert	4946
Mississippi chert	4962
chert	4970
cherty lime	4977
lime, chert	5010
Total Depth	

RECEIVED  
 STATE CORPORATION COMMISSION

MAY 23 1972

CONSERVATION DIVISION  
 Wichita, Kansas

TOPS?	
Heebner	4129
Brown Lime	4306
Lansing Kansas City	4318
Mississippi	4921