

STATE OF KANSAS
STATE CORPORATION COMMISSION


Form CP-4

WELL PLUGGING RECORD

Give All Information Completely
Make Required Affidavit
Mail or Deliver Report to:
Conservation Division
State Corporation Commission
212 No. Market
Wichita, Kansas

KIOWA County, Sec. 14 Twp. 29S Rge. 19 (E) (W)
C SW SW

Location as "NE/CNW/SW" or footage from lines
Lease Owner: PETROLEUM, INC.
Lease Name: KELLY "C" Well No. 1
Office Address: R.R. #2, GREAT BEND, KANSAS
Character of Well (completed as Oil, Gas or Dry Hole): DRY HOLE
Date well completed: Nov. 3 19 66
Application for plugging filed: Nov. 3 19 66
Application for plugging approved: Nov. 3 19 66
Plugging commenced: Nov. 3 19 66
Plugging completed: Nov. 3 19 66
Reason for abandonment of well or producing formation: NO PRODUCIBLE ZONE

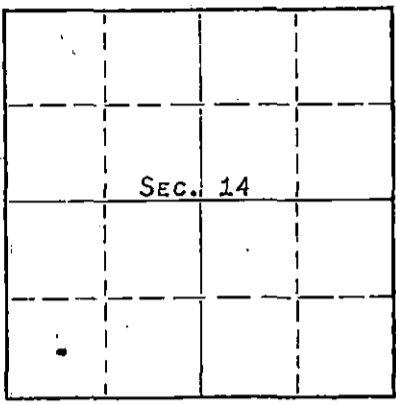

Locate well correctly on above Section Plat

If a producing well is abandoned, date of last production: NONE 19
Was permission obtained from the Conservation Division or its agents before plugging was commenced? YES

Name of Conservation Agent who supervised plugging of this well: ARCHIE ELYING
Producing formation: Depth to top: Bottom: Total Depth of Well: 5175' Feet
Show depth and thickness of all water, oil and gas formations.

OIL, GAS OR WATER RECORDS CASING RECORD

FORMATION	CONTENT	FROM	TO	SIZE	PUT IN	PULLED OUT
				8-5/8"	663'	NONE

Describe in detail the manner in which the well was plugged, indicating where the mud fluid was placed and the method or methods used in introducing it into the hole. If cement or other plugs were used, state the character of same and depth placed, from feet to feet for each plug set.

HEAVY MUD TO 450', 1/2 SACK HULLS FOLLOWED BY WOODEN PLUG, PLACED 25 SACKS CEMENT ON TOP OF PLUG. HEAVY MUD TO 40', 1/2 SACK HULLS, FOLLOWED BY WOODEN PLUG, PLACED 10 SACKS CEMENT TO BASE OF WELL CELLAR.

RECEIVED
STATE CORPORATION COMMISSION
NOV 16 1966
11-16-66
CONSERVATION DIVISION
Wichita, Kansas

(If additional description is necessary, use BACK of this sheet)
Name of Plugging Contractor: GARVEY DRILLING Co.
Address: R.R. #2, GREAT BEND, KANSAS

STATE OF KANSAS, COUNTY OF BARTON, ss.
MONTE CHADD (employee of owner) or (operator) of the above-described well, being first duly sworn on oath, says: That I have knowledge of the facts, statements, and matters herein contained and the log of the above-described well as filed and that the same are true and correct. So help me God. MONTE CHADD, DIST. PROD. SUPT.

(Signature) [Signature of Monte Chadd]

(Address)

SUBSCRIBED AND SWORN TO before me this 15 day of NOVEMBER, 19 66

My commission expires MAY 28, 1969


[Signature of Notary Public] Notary Public.

WELL LOG

COMPANY Petroleum, Incorporated
 FARM Kelly NO. C-1
 TOTAL DEPTH 5175'
 COMM. 10-19-66 COMP. 11-2-66
 CONTRACTOR Garvey Drilling Company

SEC. 14 T. 29S R. 19W
 LOC. C SW SW
 COUNTY Kiowa

CASING 8 5/8" @ 663' w/400 sx

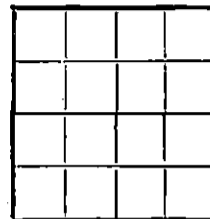

ELEVATION 2360' KB

PRODUCTION D & A

FIGURES INDICATE BOTTOM OF FORMATIONS

- 40' Clay and Sand
- 600' Shale with Sand Streaks
- 1148' Shale
- 1286' Red Bed and Shale
- 1315' Anhydrite
- 2230' Shale and Shells
- 3935' Lime and Shale
- 5024' Lime
- 5075' Lime and Shale
- 5103' Lime and Chert
- 5135' Cherty Lime
- 5175' Lime
- 5175' RTD

RECEIVED
 STATE CORPORATION COMMISSION
 NOV 16 1966
 11-16-66
 CONSERVATION DIVISION
 Wichita, Kansas

State of Kansas
 County of Barton } 66

I, Sam N. Stephens of Garvey Drilling Company
 upon oath state the above and foregoing is a true and correct copy of the log of the Kelly C-1 well.

Sam N. Stephens

Subscribed and sworn to before me this 11th day of November 19 66

My Commission Expires: November 5th, 1969

Richard Boyd
 NOTARY PUBLIC