


STATE OF KANSAS  
STATE CORPORATION COMMISSION

WELL PLUGGING RECORD

Give All Information Completely  
Make Required Affidavit  
Mail or Deliver Report to  
Conservation Division  
State Corporation Comm.  
245 North Water  
Wichita, KS 67202

Kiowa County, Sec. 14 Twp. 29S Rge. 19W E/W  
Location as "NE/CNW $\frac{1}{4}$ SW $\frac{1}{4}$ " or footage from lines \_\_\_\_\_  
C SE NW  
Lease Owner D. R. Lauck Oil Company, Inc.  
Lease Name Heinze "A" Well No. 1  
Office Address 221 S. Broadway, Suite 400, Wichita, KS 67202  
Character of Well (Completed as Oil, Gas or Dry Hole) \_\_\_\_\_  
Dry Hole

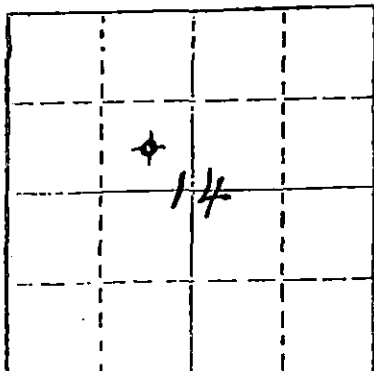

Locate well correctly on above Section Plot

Date Well completed March 12, 1981  
Application for plugging filed March 12, 1981  
Application for plugging approved March 12, 1981  
Plugging commenced March 12, 1981  
Plugging completed March 12, 1981  
Reason for abandonment of well or producing formation \_\_\_\_\_

Dry Hole  
If a producing well is abandoned, date of last production 19 \_\_\_\_\_

Was permission obtained from the Conservation Division or its agents before plugging was commenced? Yes

Name of Conservation Agent who supervised plugging of this well Wm. T. Owen  
Producing formation \_\_\_\_\_ Depth to top \_\_\_\_\_ Bottom \_\_\_\_\_ Total Depth of Well 5092'  
Show depth and thickness of all water, oil and gas formations.

OIL, GAS OR WATER RECORDS

CASING RECORD

FORMATION	CONTENT	FROM	TO	SIZE	PUT IN	PULLED OUT
		0'	681'	8-5/8"	674.47'	None

Describe in detail the manner in which the well was plugged, indicating where the mud fluid was placed and the method or methods used in introducing it into the hold. If cement or other plugs were used, state the character of same and depth placed, from \_\_\_\_\_ feet to \_\_\_\_\_ feet for each plug set.

Plugged with 50 sacks cement at 680';  
10 sacks cement at 40'; and 10 sacks cement in rat hole.

RECEIVED  
MAR 19 1981  
CONSERVATION DIVISION  
STATE OF KANSAS

(If additional description is necessary, use BACK of this sheet)


Name of Plugging Contractor Allied Cementing Co.

STATE OF KANSAS COUNTY OF SEDGWICK, ss.  
John D. Knightley (employee of owner) or (owner or operator)  
of the above-described well, being first duly sworn on oath, says: That I have knowledge of the facts, statements, and matters herein contained and the log of the above-described well as filed and that the same are true and correct. So help me God.

(Signature) [Signature]  
221 S. Broadway, Suite 400, Wichita, KS 67202  
(Address)

DESCRIBED AND SWORN TO before me this 18th day of March, 1981

My commission expires March 12, 1983

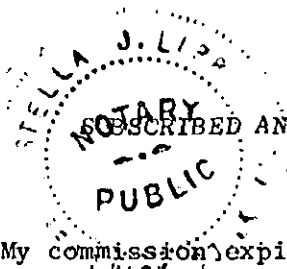

[Signature]  
Stella J. Lipps Notary Public.

D. R. Lauck Oil Company, Inc. - Heinze "A" #1  
 221 S. Broadway, Suite 400 C SE NW Sec. 14-29S-19W  
 Wichita, Kansas 67202 Kiowa County, Kansas

Contractor: D. R. Lauck Oil Company, Inc.  
 221 S. Broadway, Suite 400  
 Wichita, Kansas 67202

Commenced: February 27, 1981  
 Completed: March 12, 1981

Drillers Log

Sand, Clay, Red Bed	560
Sand, Clay, Red Bed, Lime	684
Red Bed & Shale	1720
Shale, Red Bed, & Lime	2415
Shale & Shells	2575
Shale	2830
Shale & Lime	3465
Lime & Shale	3605
Shale & Lime	3920
Lime & Shale	4150
Lime	4290
Lime & Shale	4600
Lime	4947
Lime & Shale	4947
Lime	5045
Lime & Shale	5092
Lime	5092 RTD

STATE OF KANSAS  
 COMMISSIONER OF GEOLOGY  
 RECEIVED  
 MAR 19 1981  
 3-19-81  
 CONSERVATION DIVISION  
 WICHITA, KANSAS