


STATE OF KANSAS
STATE CORPORATION COMMISSION

Give All Information Completely
Required Affidavit
Mail or Deliver Report to:
Conservation Division
State Corporation Commission
800 Bittling Building
Wichita, Kansas

WELL PLUGGING RECORD

NORTH

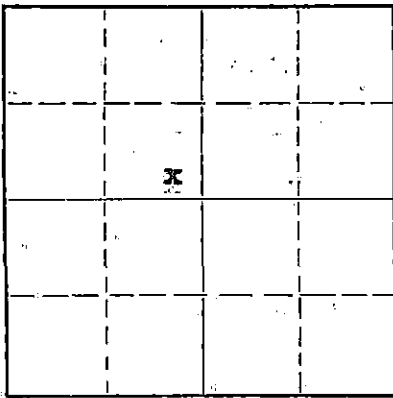

Locate well correctly on above
Section Plat

Kiowa County. Sec. 11 Twp. 29S Rge. (E) 19 (W)
Location as "NE/CNW/SW" or footage from lines C SE SE NW
Lease Owner Gulf Oil Corporation
Lease Name H. Peckham Well No. 1
Office Address Box 661, Tulsa, Oklahoma
Character of Well (completed as Oil, Gas or Dry Hole) Dry Hole
Date well completed 12-12 19 55
Application for plugging filed 2-15 19 56
Application for plugging approved 2-20 19 56
Plugging commenced 2-23 19 56
Plugging completed 2-23 19 56
Reason for abandonment of well or producing formation Dry Hole

If a producing well is abandoned, date of last production - 19 -
Was permission obtained from the Conservation Division or its agents before plugging was commenced? Yes

Name of Conservation Agent who supervised plugging of this well M. A. Rives
Producing formation - Depth to top - Bottom - Total Depth of Well PB 4975 Feet
Show depth and thickness of all water, oil and gas formations.

OIL, GAS OR WATER RECORDS

CASING RECORD

FORMATION	CONTENT	FROM	TO	SIZE	PUT IN	PULLED OUT
				8-5/8"	642'	-0-
				4-1/2"	5071'	3634'

Describe in detail the manner in which the well was plugged, indicating where the mud fluid was placed and the method or methods used in introducing it into the hole. If cement or other plugs were used, state the character of same and depth placed, from _____ feet to _____ feet for each plug set.

Pulled tubing, killed well with 70 barrels of water. Plugged back with sand from 4975' to 4860' and ran 5 sacks of cement. Pulled 118 joints and 1 nipple of 4 1/2" casing, tally 3634'. Mudded hole to 400' of surface, bridged with rock and ran 20 sacks of cement. Filled with mud to 35' of surface, bridged with rock and capped with 10 sacks of cement filling hole into cellar.

(If additional description is necessary, use BACK of this sheet)

Name of Plugging Contractor Morgan Well Plugging Service
Address 102 W. 18th St., Hutchinson, Kansas

STATE OF Kansas, COUNTY OF Barton, ss.
W. H. Duley (employee of owner) ~~owner or operator~~ of the above-described well, being first duly sworn on oath, says: That I have knowledge of the facts, statements, and matters herein contained and the log of the above-described well as filed and that the same are true and correct. So help me God.

(Signature) W. H. Duley
Box 225, Great Bend, Kansas
(Address)

SUBSCRIBED AND SWORN to before me this 27th day of February, 19 56

My commission expires October 26, 1959

STATE CORPORATION COMMISSION Notary Public.

:JRM

PLUGGING
FILE SEC 11 T 29 R 19W
BOOK 39 PAGE 24

FEB 29 1956
2-29-56
CONSERVATION DIVISION
Wichita, Kansas

WELL LOG

COMPANY: Gulf Oil Corporation

Sec. 11-29S-19W

FARM: Hilda Peckham No. 1

Loc. SE SE NW

TOTAL DEPTH - 5,082'

County - Kiowa

COMM: 11-5-55. COMP. 11-26-55.

CASING

8-5/8" - 652'
4-1/2" - 5080.76'

ELEVATION

D.F. -
Gr. -

DRILLER'S LOG

Sand & Shale	0	286
Sand & Clay	286	568
Sand, Shale & Lime	568	665
Shale & Red Bed	665	1937
Shale & Shells	1937	2265
Lime & Shale	2265	2555
Lime	2555	3166
Lime & Shale	3166	4055
Lime	4055	4125
Lime & Shale	4125	4225
Shale	4225	4276
Lime & Shale	4276	4385
Lime & Shale Stks.	4385	4450
Lime	4450	4783
Lime & Shale Stks.	4783	4834
Lime	4834	4880
Lime & Shale	4880	4914
Lime	4914	4933
Core No. 1	4933	4944
Core No. 2	4944	4978
Core No. 3	4978	4987
Core No. 4	4987	4993
Lime & Chert	4993	5082
Total Depth	5082	

Plugged back to 4975'

RECEIVED
STATE CORPORATION COMMISSION
MAR 24 1956
3-24-56
CONSERVATION DIVISION
Wichita, Kansas

PLUGGING
SEC 11-29-19W
PAGE 39 LINE 24

