

WELL PLUGGING RECORD

Give All Information Completely
Make Required Affidavit
Mail or Deliver Report to:
Conservation Division
State Corporation Commission
211 No. Broadway
Wichita, Kansas

Grant _____ County, Sec. 28 Twp. 29S Rge. 35W (E) _____ (W)

Location as "NE/CNW/SW" or footage from lines 1980' fr. E/L - 1880' fr. S/L

Lease Owner LaCima Corporation

Lease Name E. T. Hogan Well No. 1

Office Address Box 2475, Pampa, Texas

Character of Well (completed as Oil, Gas or Dry Hole) Dry Hole

Date well completed _____ May 24 19 63

Application for plugging filed _____ May 24 19 63

Application for plugging approved _____ May 24 19 63


Plugging commenced _____ May 25 19 63

Plugging completed: _____ May 25 19 63

Reason for abandonment of well or producing formation No commercial shows encountered while drilling

If a producing well is abandoned, date of last production _____ 19 _____

Was permission obtained from the Conservation Division or its agents before plugging was commenced? Yes

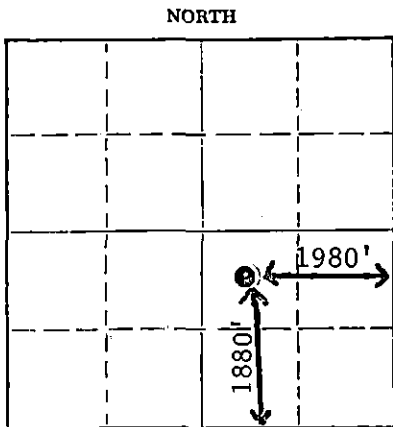

Locate well correctly on above Section Plat

Name of Conservation Agent who supervised plugging of this well Hugh Scott

Producing formation None Depth to top _____ Bottom _____ Total Depth of Well 5661 Feet

Show depth and thickness of all water, oil and gas formations.

OIL, GAS OR WATER RECORDS

CASING RECORD

FORMATION	CONTENT	FROM	TO	SIZE	PUT IN	PULLED OUT
None				8-5/8	1775'	None

Describe in detail the manner in which the well was plugged, indicating where the mud fluid was placed and the method or methods used in introducing it into the hole. If cement or other plugs were used, state the character of same and depth placed, from _____ feet to _____ feet for each plug set.

Filled hole with mud - 1st plug @ 2850' - Mixed and spotted 125 sx 50/50 Pozmix w/2% total gel displaced w/mud through 4-1/2" drill pipe. 2nd plug @ 600' - mixed 35 sx 50/50 Pozmix and displaced w/mud through 4-1/2" drill pipe - Top plug filled hole w/mud to 40' below ground level, set wooden plug filled w/ 15 sx 50/50 Pozmix to bottom of cellar.

RECEIVED
STATE CORPORATION COMMISSION

JUN 7 1963
6-7-63

CONSERVATION DIVISION
Wichita, Kansas

(If additional description is necessary, use BACK of this sheet)

Name of Plugging Contractor Sun Oil Well Cementing, Inc.

Address Box 169, Great Bend, Kansas.

STATE OF TEXAS, COUNTY OF GRAY, ss.

E.R. Sidwell, Vice Pres. LaCima Corporation (employee of owner) or (owner or operator) of the above-described well, being first duly sworn on oath, says: That I have knowledge of the facts, statements, and matters herein contained and the log of the above-described well as filed and that the same are true and correct. So help me God.

(Signature) E.R. Sidwell

P. O. Box 2475, Pampa, Texas

(Address)

SUBSCRIBED AND SWORN TO before me this 5th day of June, 19 63

Addie Mae Bryan
Addie Mae Bryan
Notary Public.

My commission expires June 1, 1965

R

LACIMA CORPORATION-
E. T. HOGAN #1

WELL RECORD:

LOCATION:

1880' fr. S/L
1980' fr. E/L
Section 28-29-35
Grant County, KansasCommenced: 5-7-63
Completed: 5-25-63
(Rotary)

CONTRACTOR:

Graham-Michaelis Drilling Co.
Liberal Division
P. O. Box 1294
Liberal, Kansas

CASING RECORD:

57 Joints 8-5/8" 24# Casing
Cemented w/575 sx Pozmix 6% Gel
2% cc and w/200 sx Common 2% ccLOG:

Sand & Red Bed	0 - 1177
Gyp, Sand, Shale & Anhydrite	1177 - 1710
Salt & Anhydrite	1710 - 1775
Red Bed & Anhydrite	1775 - 2279
Anhydrite & Shale	2279 - 2460
Lime & Shale	2460 - 4658
Lime	4658 - 4706
Lime & Shale	4706 - 4889
Lime	4889 - 4903
Lime & Shale	4903 - 5042
Lime	5042 - 5094
Lime & Shale	5094 - 5659
Lime	5659 - 5661

5661' - Total Rotary Depth