


STATE OF KANSAS  
STATE CORPORATION COMMISSION

WELL PLUGGING RECORD

Give All Information Completely  
Make Required Affidavit  
Mail or Deliver Report to  
Conservation Division  
State Corporation Comm.  
245 North Water  
Wichita, KS 67202

Grant \_\_\_\_\_ County. Sec. 31 Twp. 29 Rge. 35 E/W  
Location as "NE/CNW $\frac{1}{2}$ SW $\frac{1}{2}$ " or footage from lines \_\_\_\_\_  
2640 FNL & 1320 FEL  
Lease Owner Ashland Oil Co.  
Lease Name Williams Well No. 2-31  
Office Address Box 127, Satanta, Kansas 67870  
Character of Well (Completed as Oil, Gas or Dry Hole) \_\_\_\_\_  
Gas  
Date Well completed 8-11 1977  
Application for plugging filed 9-18 1978  
Application for plugging approved 9-19 1978  
Plugging commenced 9-26 1978  
Plugging completed 9-27 1978  
Reason for abandonment of well or producing formation \_\_\_\_\_  
N Redrilled  
If a producing well is abandoned, date of last production \_\_\_\_\_  
None 19  
Was permission obtained from the Conservation Division or  
its agents before plugging was commenced? Yes

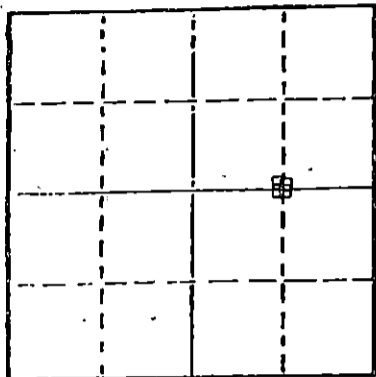

Locate well correctly on above  
Section Plot

Name of Conservation Agent who supervised plugging of this well Mr. Thomas  
Producing formation Council Grove Depth to top 2747' Bottom 2828' Total Depth of Well 2856'  
Show depth and thickness of all water, oil and gas formations.

OIL, GAS OR WATER RECORDS

CASING RECORD

FORMATION	CONTENT	FROM	TO	SIZE	PUT IN	PULLED OUT
Surface				8 5/8"	584'	0'
Production				5 1/2"	2856'	0'

Describe in detail the manner in which the well was plugged, indicating where the mud fluid was placed and the method or methods used in introducing it into the hold. If cement or other plugs were used, state the character of same and depth placed, from \_\_\_\_\_ feet to \_\_\_\_\_ feet for each plug set.

Pumped 2 sacks hulls & 20 sacks cement to 2680'  
Displaced to 550'  
Pumped 15 sacks cement 550' to 450'  
Displaced to 40'  
Put bridge & 5 sacks cement 40' to 0'.  
Cut off 8 5/8" & 5 1/2" casing 4' below ground level.

RECEIVED  
STATE CORPORATION COMMISSION  
10-10-78  
OCT 10 1978

CONSERVATION DIVISION  
Wichita, Kansas

(If additional description is necessary, use BACK of this sheet)

Name of Plugging Contractor Midwest Casing Pulling  
Box F, Sublette, Kansas 67877 Permit # 766

STATE OF KANSAS COUNTY OF Haskell, ss.  
I Edgar J. Eves (employee of owner) or (owner or operator)  
of the above-described well, being first duly sworn on oath, says: That I have knowledge of the facts, statements, and matters herein contained and the log of the above-described well as filed and that the same are true and correct. So help me God.

(Signature) Edgar J. Eves  
Box F, Sublette, Kansas 67877  
(Address)

SUBSCRIBED AND SWORN TO before me this 28th day of September, 1978

Sandra L. Eves  
Notary Public.

My commission expires 12-6-80

