

WELL PLUGGING RECORD

Give All Information Completely
Make Required Affidavit
Mail or Deliver Report to:
Conservation Division
State Corporation Commission
211 No. Broadway
Wichita, Kansas

Grant _____ County, Sec. 24 Twp. 29 Rge. 36 (E) _____ (W)

Location as "NE/CNW/SW" or footage from lines 2640' S of N & 2624' W of E Lines

Lease Owner Panhandle Eastern Pipe Line Company

Lease Name Stevesson Well No. 1-24

Office Address Box 828, Liberal, Kansas

Character of Well (completed as Oil, Gas or Dry Hole) Gas

Date well completed 12-12 1937

Application for plugging filed 7-12 1963

Application for plugging approved 7-17 1963


Plugging commenced 8-7 1963

Plugging completed 8-9 1963

Reason for abandonment of well or producing formation This well was replaced by the Stevesson #1A-24

If a producing well is abandoned, date of last production August 1963

Was permission obtained from the Conservation Division or its agents before plugging was commenced? Yes

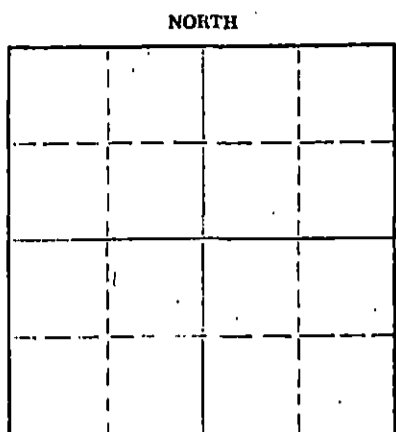

Locate well correctly on above Section Plat

Name of Conservation Agent who supervised plugging of this well Hugh Scott

Producing formation Hugoton Depth to top 2482 Bottom 2682 Total Depth of Well 2800 Feet

Show depth and thickness of all water, oil and gas formations.

OIL, GAS OR WATER RECORDS

CASING RECORD

FORMATION	CONTENT	FROM	TO	SIZE	PUT IN	PULLED OUT
				10 3/4	531'	None
				7	2480'	None

Describe in detail the manner in which the well was plugged, indicating where the mud fluid was placed and the method or methods used in introducing it into the hole. If cement or other plugs were used, state the character of same and depth placed, from _____ feet to _____ feet for each plug set.

Killed well w/50 sxs cmt & 7 sxs cotton seed hulls
Set plug at 2347', pumped mud to 800', spotted 35 sxs cmt from 381' to 361'
filled w/mud to 60'; spotted 15 sxs from 50' to surface.

RECEIVED
STATE CORPORATION COMMISSION

AUG 15 1963
8-15-63
CONSERVATION DIVISION
Wichita, Kansas

(If additional description is necessary, use BACK of this sheet)

Name of Plugging Contractor Sargents Casing Pulling Service

Address 121 W 9th, Liberal, Kansas

STATE OF Kansas COUNTY OF Seward, ss.

C. G. Melton (employee of owner) or (owner or operator) of the above-described

well, being first duly sworn on oath, says: That I have knowledge of the facts, statements, and matters herein contained and the log of the above-described well as filed and that the same are true and correct. So help me God.

(Signature) C. G. Melton

Box 828 Liberal, Kansas (Address)

SUBSCRIBED AND SWORN TO before me this 14th day of August 1963

Donald L. Carpenter
Notary Public.

My commission expires _____

DRILLER'S LOG

WELL NAME: Stevesson #1-24 ; COMPANY OPERATING: Panhandle Eastern Pipe Line Co.
 ADDRESS of COMPANY: Box 351, Liberal, Kansas
 WELL LOCATION: $\frac{1}{4}$ $\frac{1}{4}$ $\frac{1}{4}$,
2640 ft. North-of-South-line, South of North Line,
2624 ft. East-of-West-line; Sec. 24, Twp. 29, Rge. 36, Grant County, Kansas
 West of East Line;
 DRILLING STARTED 11-11, 1937; DRILLING COMPLETED 12-9, 1937
 WELL COMPLETED 12-12, 1937; WELL CONNECTED _____, 19____
 ELEVATION: 3010.9 ft. Ground Level; CHARACTER OF WELL (Oil, Gas, or Dry Hole) Gas

OIL OR GAS SANDS OR ZONES - PERFORATIONS - ACIDIZING AND FRACTURING INFORMATION					
Name	From	To	No. of Shots	Gallons Used	Kind Used
Hugoton	2 508	2 682		4000	

RECEIVED
 STATE CORPORATION COMMISSION
 OCT 8 1963
 10-8-63
 CONSERVATION DIVISION
 Wichita, Kansas

CASING RECORD

Size	Amount Set	Sacks of Cement	Amount Pulled
10 3/4	531	90	
7	2480	100	

FORMATION RECORD

Formation	Top	Bottom	Formation	Top	Bottom
Clay & Sand	0	548			
Red Bed & Shells	548	641			
Clay & Shale	641	1276			
Shale & Shells	1276	1537			
Shale & Anhydrite	1537	1814			
Shale	1814	1836			
Lime	1836	1985			
Anhydrite	1985	2032			
Shale & Lime	2032	2800			
Depth, total	2800				

RESULTS of INITIAL PRODUCTION TEST: _____