


STATE OF KANSAS
STATE CORPORATION COMMISSION

Form CP-4

WELL PLUGGING RECORD

Give All Information Completely
Make Required Affidavit
Mail or Deliver Report to:
Conservation Division
State Corporation Commission
212 No. Market
Wichita, Kansas 67202

NORTH

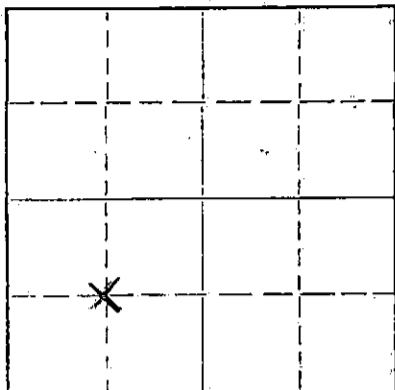

Locate well correctly on above
Section Flat

Kiowa County. Sec. 20 Twp. 29 Rge. 18 (E) W (W)
Location as "NE/CNW/SW" or footage from lines C SE SE
Lease Owner Misco Supply Co.
Lease Name Beals Well No. # 1
Office Address 257 North Broadway ; Wichita, Ks. 67202
Character of Well (completed as Oil, Gas or Dry Hole)
Date well completed 19
Application for plugging filed September 19 71
Application for plugging approved September 19 71
Plugging commenced October 9 19 71
Plugging completed November 6 19 71
Reason for abandonment of well or producing formation

If a producing well is abandoned, date of last production 19
Was permission obtained from the Conservation Division or its agents before plugging was commenced? Yes

Name of Conservation Agent who supervised plugging of this well Russell Biberstein
Producing formation Depth to top Bottom Total Depth of Well Feet
Show depth and thickness of all water, oil and gas formations.

OIL, GAS OR WATER RECORDS

CASING RECORD

| FORMATION | CONTENT | FROM | TO | SIZE | PUT IN | PULLED OUT |
|-----------|---------|------|----|--------|--------|------------|
| | | | | 8 5/8" | 412 | None |
| | | | | 5 1/2" | 5099 | 3028 |
| | | | | | | |
| | | | | | | |
| | | | | | | |
| | | | | | | |
| | | | | | | |

Describe in detail the manner in which the well was plugged, indicating where the mud fluid was placed and the method or methods used in introducing it into the hole. If cement or other plugs were used, state the character of same and depth placed, from feet to feet for each plug set.

October 9, 1971 Plugged off bottom. Dumped sand to 4900'. Mixed and dumped 5 sx of cement to 4860'.
November 6, 1971 Plugged off top. Set 20' rock bridge at 260'. Filled 8 5/8" surface casing from 260' to base of cellar with 3000 lb. P.S.I. ready-mix concrete.

RECEIVED
STATE CORPORATION COMMISSION
NOV 22 1971
CONSERVATION DIVISION
Wichita, Kansas
11-22-71

(If additional description is necessary, use BACK of this sheet)
Name of Plugging Contractor RUSS CASING PULLING, INC.
Address P. O. Box 1082 Great Bend, Kansas 67530

STATE OF Kansas, COUNTY OF Sedgwick, ss.
Thomas R. Sproul (employee of owner) of the above-described

well, being first duly sworn on oath, says: That I have knowledge of the facts, statements, and matters herein contained and the log of the above-described well filed and that the same are true and correct. So help me God.

(Signature) Thomas R Sproul
257 N. Broadway, Wichita, Kansas (Address)

SUBSCRIBED AND SWORN to before me this 19th day of November, 1971



My commission expires March 22, 1972
Celeste Kinzie, Notary Public.

WELL LOG BUREAU--KANSAS GEOLOGICAL SOCIETY
508 East Murdock, Wichita, Kansas


COPY

Company- GULF OIL CORP.
Farm- Hazel Beals No. 1

SEC. 20 T. 29 R. 18W
C SE SE
601' WEL & 673' NSL SE 1/4

Total Depth: 5100'
Comm. 5-9-57 Comp. 5-27-57
Shot or Treated.
Contractor.
Issued. 12-28-57

County Kiowa
KANSAS

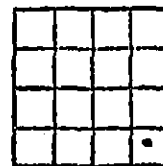

Elevation. 2213'

Production. Pot. 6 BO/150 BW in 24 hrs.

CASING:

8 5/8" 412' w/225 sx cem.
5 1/2" 5099' w/125 sx cem.

Figures indicate Bottom of Formations.

| | |
|-----------------|------|
| clay | 70 |
| clay-shale | 355 |
| shale-red bed | 413 |
| red bed | 1221 |
| shale | 1861 |
| shale-lime stks | 2320 |
| lime | 2542 |
| lime-shale | 2633 |
| lime | 3077 |
| lime-shale | 3270 |
| shale | 3417 |
| lime-shale | 4012 |
| lime | 4064 |
| lime-shale | 4449 |
| lime | 4800 |
| lime-shale | 4845 |
| lime | 4901 |
| lime-chert | 4970 |
| chert | 5011 |
| lime | 5100 |
| Total Depth | |

RECEIVED
STATE CORPORATION COMMISSION
SEP 27 1971
CONSERVATION DIVISION
Wichita, Kansas

9-27-71

| | | |
|---------------------|--------|-------|
| TOPS: | Sample | Schl. |
| Heebner | 4120 | 4120 |
| Douglas | 4149 | 4149 |
| Brown lime | 4293 | 4274 |
| Jansing-Kansas City | 4302 | 4311 |
| Marmaton | 4728 | 4726 |
| Mississippi chert | 4912 | 4912 |
| Mississippi lime | 5002 | 5002 |

Perf. 4980-88' w/250 gals.
Squeezed Perf. 4980-88' w/50 sx. cem
Perf. 4966-72' w/250 gals.
Squeezed Perf. 4966-72' w/38 sx. cem
Perf. 4968-72' w/200 gals.
Squeezed Perf. 4968-72' w/50 sx. cem.
Perf. 4954-58' Reperf. 4954-58' w/200 gals.
Squeezed perf. 4954-58' w/35 sx cem.
Perf. 4950-52' w/200 gals.

Ran Schlumberger log.