


STATE OF KANSAS
STATE CORPORATION COMMISSION

WELL PLUGGING RECORD

Give All Information Completely
Make Required Affidavit
Mail or Deliver Report to:
Conservation Division
State Corporation Commission
211 No. Broadway
Wichita, Kansas

Kiowa County, Sec. 20 Twp. 29S Rge. 18 (X) (W)

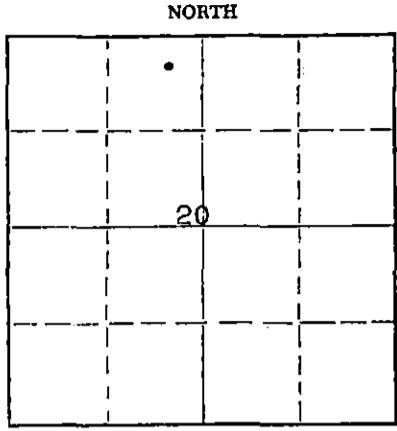

Location as "NE/CNW/SW" or footage from lines C NE NE NW
Lease Owner Gulf Oil Corporation et al
Lease Name Franklin Nichols Well No. 1
Office Address P.O. Box 9010, Amarillo, Texas 79105
Character of Well (completed as Oil, Gas or Dry Hole) Gas
Date well completed 2-28 19 55
Application for plugging filed 2-16 19 70
Application for plugging approved 2-17 19 70
Plugging commenced 4-15 19 70
Plugging completed 4-21 19 70
Reason for abandonment of well or producing formation Producing below economic limit.
If a producing well is abandoned, date of last production January 19 70
Was permission obtained from the Conservation Division or its agents before plugging was commenced? Yes

Locate well correctly on above Section Plat

Name of Conservation Agent who supervised plugging of this well Russel Biberstien
Producing formation Mississippi Depth to top 4956' Bottom 5035' Total Depth of Well 5035 Feet
Show depth and thickness of all water, oil and gas formations.

OIL, GAS OR WATER RECORDS

CASING RECORD

FORMATION	CONTENT	FROM	TO	SIZE	PUT IN	PULLED OUT
Mississippi	Gas	4956'	5035'	10 3/4"	353'	None
Lansing	Water	4340'	4848'	5 1/2"	5259'	3412'
Douglas	Water	4146'	4192'			

Describe in detail the manner in which the well was plugged, indicating where the mud fluid was placed and the method or methods used in introducing it into the hole. If cement or other plugs were used, state the character of same and depth placed, from _____ feet to _____ feet for each plug set.

Pulled rods and tubing
Pumped 100 sack cement down 5 1/2" casing to 4700' with 37 viscosity mud.
Cement plug 4985' - 4700'
Mud 4700' to 380'
Ripped off and pulled 3412' 5 1/2" 14# casing.
Ran tubing and spotted 40 sack cement plug from 380' to 306'. Mud from 306' to 55'
Built rock bridge from 55' to 45'.
Filled hole with cement from 45' to bottom of cellar.

RECEIVED
STATE CORPORATION COMMISSION
MAY 6 1970
CONSERVATION DIVISION
Wichita, Kansas

5-6-70

(If additional description is necessary, use BACK of this sheet)

Name of Plugging Contractor Clark Oil Field Service
Address Medicine Lodge, Kansas

STATE OF Texas, COUNTY OF Potter, ss. J. D. Richards (employee of owner) or (owner or operator) of the above-described well, being first duly sworn on oath, says: That I have knowledge of the facts, statements, and matters herein contained and the log of the above-described well as filed and that the same are true and correct. So help me God.

(Signature) J. D. Richards
Gulf Oil Corporation, P.O. Box 9010, Amarillo
Texas 79105 (Address)

SUBSCRIBED AND SWORN TO before me this 4th day of May, 19 70
My commission expires 6-1-71
Herb B. Leath Notary Public.

RECEIVED
 STATE CORPORATION COMMISSION
 FEB 17 1970
 CONSERVATION DIVISION
 Wichita, Kansas

2-17-70

FORMATION RECORD

	From	To		From	To
Red Bed & Sand	0	161	Lime & Shale		4646
Red Bed & Lime		350	Lime		4682
Lime		355	Lime & Shale		4719
Red Bed, Sand & Shale		1080	Lime, Shale & Chert		4746
Shale & Lime		1407	Lime		4772
Red Bed & Lime		1792	Lime & Shale		4818
Shale & Lime		2345	Lime		4862
Sandy Lime		2445	Lime & Shale		4885
Lime		2545	Lime, Shale & Chert		4921
Lime & Shale		2720	Lime		4969
Lime		2773	Cored		5006
Shale		2793	Shale & Chert		5027
Lime & Shale		2928	Lime		5040
Shale		3068	Chert & Lime		5063
Lime & Shale		3141	Lime & Shale		5077
Shale & Lime Shells		3220	Lime, Shale & Chert		5114
Sandy Lime & Shale		3264	Shale & Lime		5302
Lime & Shale		4018	Lime, Chert & Shale		5316
Lime & Sand		4050	Lime		5415
Lime & Shale		4100	Lime, Chat & Shale		5435
Lime		4195	Lime		5448
Shale		4209	Lime & Shale		5458
Lime & Shale		4233	Lime		5564
Lime, Sand & Shale		4270	Sand & Shale		5569
Shale		4340	Lime & Dolomite		5605
Lime & Shale		4370	Lime		5630
Lime		4597	Total Depth		5630

FRANKLIN Nichols #1

WELLING (Well Records)