


Give All Information Completely  
Make Required Affidavit  
Mail or Deliver Report to:  
Conservation Division  
State Corporation Commission  
212 No. Market  
Wichita, Kansas

WELL PLUGGING RECORD

KIOWA County, Sec. 15 Twp. 29s Rge. 18 (R) (W)

Location as "NE/CNW%SW%" or footage from lines C NE SW  
Lease Owner PETROLEUM, INC.,  
Lease Name DARGEL "B" Well No. 1  
Office Address R.R. #2, GREAT BEND, KANSAS  
Character of Well (completed as Oil, Gas or Dry Hole) DRY HOLE  
Date well completed JUNE 22 1966  
Application for plugging filed JUNE 22 19 66  
Application for plugging approved JUNE 22 19 66  
Plugging commenced JUNE 22 19 66  
Plugging completed JUNE 22 19 66  
Reason for abandonment of well or producing formation NO PRODUCIBLE ZONE

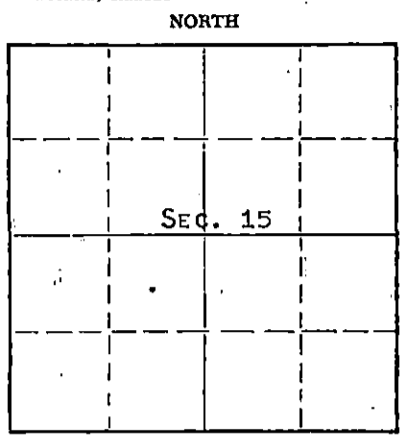

Locate well correctly on above Section Plat

If a producing well is abandoned, date of last production NONE 19  
Was permission obtained from the Conservation Division or its agents before plugging was commenced? YES

Name of Conservation Agent who supervised plugging of this well ARCHIE ELVING  
Producing formation \_\_\_\_\_ Depth to top \_\_\_\_\_ Bottom \_\_\_\_\_ Total Depth of Well 5048' Feet  
Show depth and thickness of all water, oil and gas formations.

OIL, GAS OR WATER RECORDS

CASING RECORD

FORMATION	CONTENT	FROM	TO	SIZE	PUT IN	PULLED OUT
				8-5/8"	462'	NONE

Describe in detail the manner in which the well was plugged, indicating where the mud fluid was placed and the method or methods used in introducing it into the hole. If cement or other plugs were used, state the character of same and depth placed, from \_\_\_\_\_ feet to \_\_\_\_\_ feet for each plug set.

MUDDED UP WITH HEAVY MUD TO 300', FOLLOWED BY WOODEN PLUG, PLACED 25 SACKS CEMENT ON TOP OF PLUG. MUDDED UP WITH HEAVY MUD TO 40' FOLLOWED BY WOODEN PLUG, PLACED 10 SACKS CEMENT ON TOP OF PLUG TO BASE OF WELL CELLAR.

RECEIVED  
STATE CORPORATION COMMISSION  
JUL 5 1966  
7-5-66  
CONSERVATION DIVISION  
Wichita, Kansas

(If additional description is necessary, use BACK of this sheet)

Name of Plugging Contractor GARVEY DRILLING COMPANY  
Address R.R. #2, GREAT BEND, KANSAS

STATE OF KANSAS, COUNTY OF BARTON, ss. MONTE CHADD (employee of owner) or (owner or operator) of the above-described

well, being first duly sworn on oath, says: That I have knowledge of the facts, statements, and matters herein contained and the log of the above-described well as filed and that the same are true and correct. So help me God. MONTE CHADD, DIST. PROD. SUPT.

(Signature) [Signature] R.R. #2, GREAT BEND, KANSAS (Address)

SUBSCRIBED AND SWORN TO before me this 1 day of JULY, 19 66

My commission expires MAY 28, 1969

[Signature] Notary Public.

# WELL LOG

COMPANY Petroleum, Inc.

SEC. 15 T. 29S R. 18W

FARM Dargel

NO. B-1

LOC. 1980' North of South  
1980' East of West line

TOTAL DEPTH 5048'


COUNTY Kiowa

COMM. 6-9-66

COMP. 6-22-66

CONTRACTOR Garvey Drilling Company

CASING 8 5/8" @ 462' w/300 sx

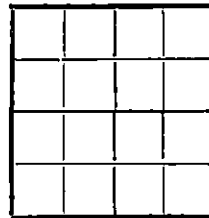

ELEVATION 2197' DF

PRODUCTION D & A

FIGURES INDICATE BOTTOM OF FORMATIONS

- 45' Clay and Sand
- 160' Sand
- 460' Clay and Sand
- 545' Red Bed and Shale
- 985' Shale, Red Bed and Shells
- 1615' Shale and Red Bed
- 2215' Shale and Lime
- 3117' Lime and Shale
- 3173' Shale and Lime
- 4306' Lime and Shale
- 4490' Lime
- 4545' Lime and Chert
- 4860' Lime
- 4943' Lime and Chert
- 4963' Cherty Lime
- 5000' Chert and Lime
- 5048' Lime
- 5048' RTD

**RECEIVED**  
STATE CORPORATION COMMISSION  
JUL 8 1966  
CONSERVATION DIVISION  
Wichita, Kansas  
7-5-66

State of Kansas }  
County of Barton } SS

I, Sam N. Stephens of Garvey Drilling Company

upon oath state the above and foregoing is a true and correct copy of the log of the Dargel B-1 well.

Sam N. Stephens

Subscribed and sworn to before me this 30th day of June 19 66

My Commission Expires: November 5, 1969

Richard B. Boye  
NOTARY PUBLIC