


STATE OF KANSAS
STATE CORPORATION COMMISSION

Form CP-4

Give All Information Completely
Make Required Affidavit
Mail or Deliver Report to:
Conservation Division
State Corporation Commission
P. O. Box 17027
Wichita, Kansas 67217
NORTH

WELL PLUGGING RECORD

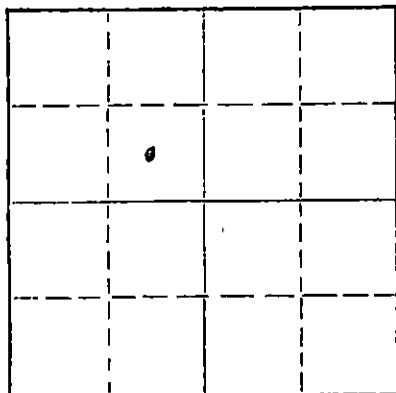

Locate well correctly on above
Section Plat

Kiowa County, Sec. 10 Twp. 29S Rge. 18 (E) W (W)
C SE NW
Location as "NE/CNW/SW" or footage from lines
Lease Owner Allen & Parker
Lease Name Vieux Well No. 1
Office Address Box 906, Perryton, Texas
Character of Well (completed as Oil, Gas or Dry Hole) Dry Hole
Date well completed 8-26- 19 72
Application for plugging filed 8-26 19 72
Application for plugging approved 8-26 19 72
Plugging commenced 8-26 19 72
Plugging completed 8-26 19 72
Reason for abandonment of well or producing formation Dry Hole

If a producing well is abandoned, date of last production 19
Was permission obtained from the Conservation Division or its agents before plugging was commenced? Yes

Name of Conservation Agent who supervised plugging of this well Russ Beiberstien
Producing formation Depth to top Bottom Total Depth of Well Feet
Show depth and thickness of all water, oil and gas formations.

OIL, GAS OR WATER RECORDS

CASING RECORD

FORMATION	CONTENT	FROM	TO	SIZE	PUT IN	PULLED OUT
Surface pipe		-0-	396	8 5/8"	396	None

Describe in detail the manner in which the well was plugged, indicating where the mud fluid was placed and the method or methods used in introducing it into the hole. If cement or other plugs were used, state the character of same and depth placed, from feet to feet for each plug set.

- Filled hole with heavy mud.
- #1 plug set @ 350 feet with 40 sks. cement.
- #2 plug set @ 40 feet with 15 sks. cement.
- #3 plug set in rat hole with 2 sks. cement.

RECEIVED
STATE CORPORATION COMMISSION
AUG 31 1972
CONSERVATION DIVISION
Wichita, Kansas

8-31-72

(If additional description is necessary, use BACK of this sheet)
Name of Plugging Contractor Sweetman Drilling, Inc.
Address Box 645, Great Bend, Kansas 67530


STATE OF Kansas, COUNTY OF Barton, ss.
Gary L. Hawk (employee of owner) or (owner or operator) of the above-described

well, being first duly sworn on oath, says: That I have knowledge of the facts, statements, and matters herein contained and the log of the above described well as filed and that the same are true and correct. So help me God.

(Signature) Gary L. Hawk
Box 645, Great Bend, Kansas 67530
(Address)

Subscribed and SWORN to before me this 30th day of August, 1972.
Mary Ann Schwamborn
Notary Public.

7-10-73

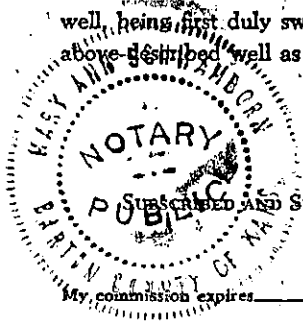

WELL LOG
Vieux #1
C SE NW 10-29S-18W
Kiowa County, Kansas

Name of Operator: Allen & Parker
Box 906
Perryton, Texas 79070

Date Completed: August 26, 1972

FROM	TO	
0	216	Sand
216	2175	Shale
2175	4395	Shale and lime
4395	4996	Lime
4996		Total Depth

RECEIVED
STATE CORPORATION COMMISSION
AUG 31 1972
8-31-72
CONSERVATION DIVISION
Wichita, Kansas

STATE OF KANSAS
COUNTY OF BARTON ss

Gary L. Hawk, Secretary of Sweetman Drilling, Inc., being first duly sworn on oath says: That I have knowledge of the facts, statements and matters herein contained and the log of the above described well as filed and that the same are true and correct.

Gary L. Hawk

Gary L. Hawk

Subscribed and sworn before me this 30th day of August, 1972.

Mary Ann Schwaborn

Notary Public Barton County

My Commission Expires 7-10-73

