


STATE OF KANSAS
STATE CORPORATION COMMISSION

Form CP-4

Give All Information Completely
Make Required Affidavit
Mail or Deliver Report to:
Conservation Division
State Corporation Commission
P. O. Box 17027
Wichita, Kansas 67217
NORTH

WELL PLUGGING RECORD

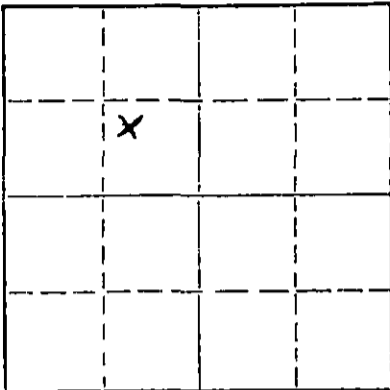

Locate well correctly on above
Section Plat

Kiowa County, Sec. 34 Twp. 29 Rge. 18 (E) W (W)
Location as "NE/CNWxSWx" or footage from lines NW SE NW
Lease Owner Misco Supply Co.
Lease Name Schmidt 'A' Well No. # 4
Office Address 257 N. Bdwy. ; Wichita, Kansas 67202
Character of Well (completed as Oil, Gas or Dry Hole)
Date well completed 19
Application for plugging filed March 1972
Application for plugging approved March 1972
Plugging commenced April 8 1972
Plugging completed April 20 1972
Reason for abandonment of well or producing formation

If a producing well is abandoned, date of last production 19
Was permission obtained from the Conservation Division or its agents before plugging was commenced? Yes

Name of Conservation Agent who supervised plugging of this well Russell Biberstein
Producing formation Depth to top Bottom Total Depth of Well Feet
Show depth and thickness of all water, oil and gas formations.

OIL, GAS OR WATER RECORDS

CASING RECORD

FORMATION	CONTENT	FROM	TO	SIZE	PUT IN	PULLED OUT
				8 5/8"	407	None
				5 1/2"	4978	2665

Describe in detail the manner in which the well was plugged, indicating where the mud fluid was placed and the method or methods used in introducing it into the hole. If cement or other plugs were used, state the character of same and depth placed, from feet to feet for each plug set.

April 8, 1972 Plugged off bottom. Dumped sand to 4900'. Mixed and dumped 5 sx of cement.

April 20, 1972 Plugged off top. Set 10' rock bridge at 220'. Filled 8 5/8" surface casing from 220' to base of cellar with 3000 lb. P.S.I. ready-mix concrete.

RECEIVED
STATE CORPORATION COMMISSION

MAY 26 1972

5-26-72

CONSERVATION DIVISION
Wichita, Kansas

(If additional description is necessary, use BACK of this sheet)

Name of Plugging Contractor RUSS CASING PULLING, INC.
Address P. O. Box 1082 ; Great Bend, Kansas 67530

STATE OF Kansas, COUNTY OF Sedgewick, ss.
Thomas R. Spraul (employed of owner) or (owner or operator) of the above-described well, being first duly sworn on oath, says: That I have knowledge of the facts, statements, and matters herein contained and the log of the above-described well as filed and that the same are true and correct. So help me God.

(Signature) Thomas R. Spraul
257 N. Broadway, Wichita, Kans.
(Address)

Notarized and sworn to before me this 25th day of May, 1972



Celeste Kinzie
Notary Public.

15-097-10183-0000

COPY


WELL LOG BUREAU—KANSAS GEOLOGICAL SOCIETY
508 East Murdock, Wichita, Kansas

Company- SUNRAY MID-CONTINENT OIL CO.
Farm- Carl Schmidt "A" No. 4

SEC. 34 T. 29 R. 18W
C SE NW

Total Depth. 4980'
Comm. 6-18-60 Comp. 6-30-60
Shot or Treated.
Contractor. Stickle Drig. Co.
Issued. 11-5-60

County Kiowa
KANSAS

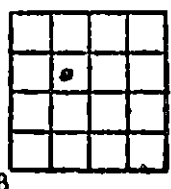

Elevation. 2196' RB

Production. Flow 6 hrs, 90 BO
6 BW w/393 MCFG

CASING:

8 5/8" 407' cem w/350 sx.
5 1/2" 4978' cem w/150 sx.

Figures Indicate Bottom of Formations.

shale & shells	2060
shale & lime	2325
lime & shale	2540
lime	3050
shale & lime streaks	3100
shale & lime	3580
shale	3700
shale & lime	3835
lime & shale	3921
lime	4015
lime & shale	4372
lime	4980
Total Depth	

TOPS:
Mississippi 4927

RECEIVED
STATE CORPORATION COMMISSION
SEP 27 1971
CONSERVATION DIVISION
Wichita, Kansas

9-27-71