

STATE CORPORATION COMMISSION OF KANSAS
OIL & GAS CONSERVATION DIVISION

WELL COMPLETION OR RECOMPLETION FORM
ACO-1 WELL HISTORY

DESCRIPTION OF WELL AND LEASE

Operator: license # 5363
name BEREXCO INC.
address 970 Fourth Financial Center
City/State/Zip Wichita, KS 67202

Operator Contact Person Evan Mayhew
Phone 316-265-3311

Contractor: license # 5147
name BEREDCO INC.

Wellsite Geologist
Phone

PURCHASER Central Crude

Designate Type of Completion
 New Well Re-Entry Workover

Oil SWD Temp Abd
 Gas Inj Delayed Comp.
 Dry Other (Core, Water Supply etc.)

If OWWO: old well info as follows:
Operator
Well Name
Comp. Date Old Total Depth

WELL HISTORY

Drilling Method: Mud Rotary Air Rotary Cable

7/02/87 7/16/87 9-16-87
Spud Date Date Reached TD Completion Date

5800' 5390'
Total Depth PBT

Amount of Surface Pipe Set and Cemented at 1847' feet

Multiple Stage Cementing Collar Used? Yes No

If Yes, Show Depth Set 3501 feet

If alternate 2 completion, cement circulated
from feet depth to w/ SX cmt

API NO. 15 081-20,450-0000

County Haskell

C. SE NW Sec 13 Twp 29s Rge 33w West

3300 Ft North from Southeast Corner of Section
3150 Ft West from Southeast Corner of Section
(Note: locate well in section plat below)


Lease Name Wright Trust Well# 3-13

Field Name U.S. 83

Producing Formation Morrow

Elevation: Ground 2926 KB 2938

Section Plat

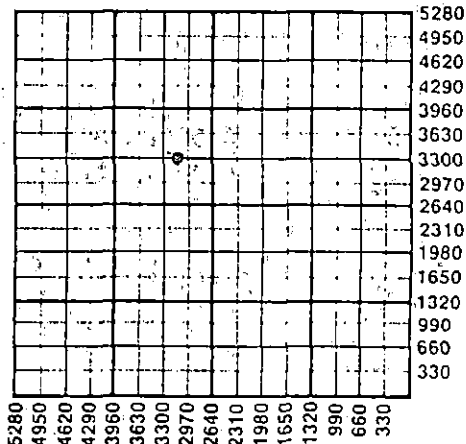

WATER SUPPLY INFORMATION

Source of Water:

Division of Water Resources Permit #

Groundwater Ft North From Southeast Corner and
(Well) Ft. West From Southeast Corner of
Sec Twp Rge East West

Surface Water Ft North From Southeast Corner and
(Stream, Pond etc.) Ft West From Southeast Corner
Sec Twp Rge East West

Other (explain) Hauled Water
(purchased from city, R.W.D.#)

Disposition of Produced Water: Disposal
 Repressuring

Docket # Hauled by Latham
Water service to their own SWD well.

INSTRUCTIONS: This form shall be completed in duplicate and filed with the Kansas Corporation Commission, 200 Colorado Derby Building, Wichita, Kansas 67202, within 90 days after completion or recompletion of any well. Rules 82-3-130 and 82-3-107 apply.

Information on side two of this form will be held confidential for a period of 12 months if requested in writing and submitted with the form. See rule 82-3-107 for confidentiality in excess of 12 months.

One copy of all wireline logs and drillers time-log shall be attached with this form. Submit CP-4 form with all plugged wells. Submit CP-111 form with all temporarily abandoned wells.

All requirements of the statutes, rules, and regulations promulgated to regulate the oil and gas industry have been fully complied with and the statements herein are complete and correct to the best of my knowledge.


Signature Evan C. Mayhew

Title Engineer Date 10-26-87

Subscribed and sworn to before me this 26 day of October 19 87

Notary Public Date: Commission Expires 3-20-90

K.C.C. OFFICE USE ONLY
 Letter of Confidentiality Attached
 Wireline Log Received
 Drillers Timelog Received
Distribution
 KCC SWD/Rep NGPA
 KGS Plug Other
(Specify)
10-30-1987
OCT 30 1987

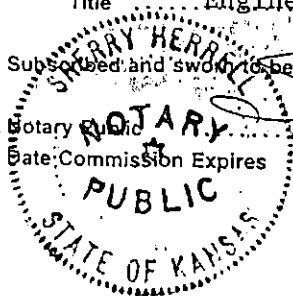

P

Sec. 13 Twp. 29 Rge. 33W