

SIDE ONE

(Rules 82-3-130 and 82-3-107)

DOCKET NO. NP \_\_\_\_\_

This form shall be filed with the Kansas Corporation Commission, 200 Colorado Derby Building, Wichita, Kansas 67202, within ninety (90) days after the completion of a well, regardless of how the well was completed.

FOR INFORMATION REGARDING THE NUMBER OF COPIES TO BE FILED AND APPLICATIONS REQUIRING COPIES OF ACO-1 FORMS SEE PAGE TWO (2), SIDE TWO (2) OF THIS FORM.

Letter requesting confidentiality attached.

Attach ONE COPY of EACH wireline log run (i.e. electrical log, sonic log, gamma ray neutron log etc.)\*\*\*Check here if NO logs were run \_\_\_\_\_.

PLEASE FILL IN ALL INFORMATION. IF NOT AVAILABLE, INDICATE. IF INFORMATION LATER BECOMES AVAILABLE, SUBMIT BY LETTER.

LICENSE # 5004 EXPIRATION DATE July 1, 1984

OPERATOR VINCENT OIL CORPORATION API NO. 15-097-20,966-0000

ADDRESS 125 N. Market, Wichita, Ks. 67202 COUNTY Kiowa

FIELD Nichols

\*\* CONTACT PERSON Ruth Benjamin PROD. FORMATION \_\_\_\_\_  
PHONE (316)262-3573 Indicate if new pay.

PURCHASER Inland Crude Purchasing Corporation LEASE Unruh

ADDRESS 200 Douglas Bldg. WELL NO. #1  
Wichita, Kansas 67202 WELL LOCATION C N½ NW¼ SE¼


DRILLING CONTRACTOR Wheatstate Drilling, Inc. 330 Ft. from North Line and

ADDRESS P. O. Box 329 1980 Ft. from East Line of   
Pratt, Kansas 67124 the SE¼ (Qtr.) SEC 22 TWP 29 RGE 18  (W).

PLUGGING CONTRACTOR N/A  
ADDRESS \_\_\_\_\_

WELL PLAT

(Office Use Only)

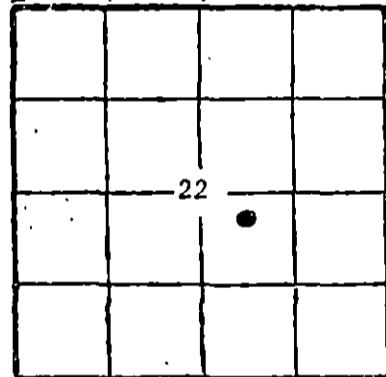

KCC   
KGS   
SWD/REP \_\_\_\_\_  
PLG. \_\_\_\_\_  
NGPA \_\_\_\_\_

TOTAL DEPTH 4945 PBTD \_\_\_\_\_

SPUD DATE 10-5-83 DATE COMPLETED 01/03/84

ELEV: GR 2159 DF \_\_\_\_\_ KB 2166

DRILLED WITH (CABLE)  (ROTARY) (AIR) TOOLS.

DOCKET NO. OF DISPOSAL OR REPRESSURING WELL BEING USED TO DISPOSE OF WATER FROM THIS LEASE \_\_\_\_\_

Amount of surface pipe set and cemented 504 DV Tool Used? \_\_\_\_\_

TYPE OF COMPLETION THIS AFFIDAVIT APPLIES TO: (Circle ONE) -  Oil Shut-in Gas, Gas, Dry, Disposal, Injection, Temporarily Abandoned. If OWWO, indicate type of re-completion \_\_\_\_\_. Other completion \_\_\_\_\_. NGPA filing \_\_\_\_\_.

ALL REQUIREMENTS OF THE STATUTES, RULES AND REGULATIONS PROMULGATED TO REGULATE THE OIL AND GAS INDUSTRY HAVE BEEN FULLY COMPLIED WITH.

A F F I D A V I T

RICHARD A. HIEBSCH, being of lawful age, hereby certifies that:

I am the Affiant, and I am familiar with the contents of the foregoing Affidavit. The statements and allegations contained therein are true and correct.

Richard A. Hiebsch  
(Name)

SUBSCRIBED AND SWORN TO BEFORE ME this 6th day of January

19 84.



Ruth N. Benjamin  
(NOTARY PUBLIC)  
Ruth N. Benjamin

MY COMMISSION EXPIRES: June 17, 1985.

\*\* The person who can be reached by phone regarding any STATE CORPORATION CONCERNING this information.

RECEIVED

1-10-84  
JAN 10 1984