

This form shall be filed in duplicate with the Kansas Corporation Commission, 200 Colorado Derby Building, Wichita, Kansas 67202, within ten days after the completion of the well, regardless of how the well was completed.

Attach separate letter of request if the information is to be held confidential. If confidential, only file one copy. Information on side one will be of public record and side two will then be held confidential.

Circle one: Oil, Gas, Dry, SWD, OWWO, Injection. Type and complete ALL sections.

Applications must be filed for dual completion, commingling, SWD and injection, T.A.

Attach wireline logs (i.e. electrical log, sonic log, gamma ray neutron log, etc.).

KCC # (316) 263-3238. (Rules 82-2-105 & 82-2-125)

OPERATOR Raymond Oil Company, Inc.

API NO 5-097-20,873-0060

ADDRESS One Main Place, Suite 900
Wichita, Kansas 67202

COUNTY Kiowa
FIELD

**CONTACT PERSON Kathleen Pipes
PHONE 267-4214

PROD. FORMATION
LEASE Chadd

PURCHASER
ADDRESS


WELL NO. #1
WELL LOCATION C S/2 NW/4

DRILLING Contractor Murfin Drilling Company
ADDRESS 617 Union Center
Wichita, Kansas 67202

660 Ft. from S. Line and
1320 Ft. from W. Line of
the NW/4 SEC. 5 TWP. 29S RGE. 19W

PLUGGING Contractor Murfin Drilling Company
ADDRESS 617 Union Center
Wichita, Kansas 67202

WELL PLAT

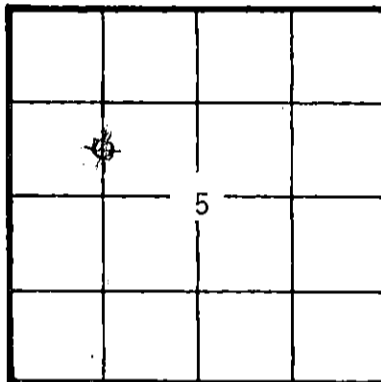

KCC
KGS
(Office Use)

TOTAL DEPTH 5050' PBDT

SPUD DATE 4-5-82 DATE COMPLETED 4-15-82

ELEV: GR 2343' DF 2352' KB 2354'

DRILLED WITH (CABLE) (ROTARY) (AIR) TOOLS

Amount of surface pipe set and cemented 650' W/400 sx. DV Tool Used?

A F F I D A V I T

STATE OF Kansas, COUNTY OF Sedgwick SS, I,

Patrick R. Raymond OF LAWFUL AGE, BEING FIRST DULY SWORN UPON HIS OATH,

DEPOSES THAT HE IS Vice-President (FOR)(OF) Raymond Oil Company, Inc.

OPERATOR OF THE Chadd LEASE, AND IS DULY AUTHORIZED TO MAKE

THIS AFFIDAVIT FOR AND ON THE BEHALF OF SAID OPERATOR, THAT WELL NO. 1 ON

SAID LEASE HAS BEEN COMPLETED AS OF THE 15th DAY OF April, 19 82, AND THAT

ALL INFORMATION ENTERED HEREIN WITH RESPECT TO SAID WELL IS TRUE AND CORRECT.

FURTHER AFFIANT SAITH, NOT.

STATE RECEIVED APR 23 1982

SUBSCRIBED AND SWORN BEFORE ME THIS 21st DAY OF April, 19 82

(s) Patrick R. Raymond, Vice-President

APR 23 1982
CONSERVATION DIVISION
Wichita
MY COMMISSION EXPIRES: March 22, 1983

NOTARY PUBLIC
Kathleen Pipes

**The person who can be reached by phone regarding any questions concerning this information. Within 45 days of completion, a witnessed initial test by the Commission is required if the well produces more than 25 BOPD or is located in a Basic Order Pool.

SIDE TWO

WELL LOG

SHOW GEOLOGICAL MARKERS, LOGS RUN, OR OTHER DESCRIPTIVE INFORMATION.

Show all important zones of porosity and contents thereof; cored intervals, and all drill-stem tests, including depth interval tested, cushion used, time tool open, flowing and shut-in pressures, and recoveries.

FORMATION DESCRIPTION, CONTENTS, ETC.	TOP	BOTTOM	NAME	DEPTH
DST #1 30-60-30-60 1st open: Strong blo 2nd open: Strong blo, incr. GTS 25" - TSTM Rec, 30' mud- 30' black Sulfer water IFP 24-24# SIP 1532-1532# FFP 24-24# D & A Plugged 4-15-82	5009	5020	Log Tops Cottonwood Wabaunsee Statler Tarkio Howard Topeka Heebner Lansing Cherokee Mississippi LTD	 3120 3429 3560 3612 3769 3861 4202 4374 4928 5000 5050

Report of all strings set — surface, intermediate, production, etc. **CASING RECORD** (New) or (Used)

Purpose of string	Size hole drilled	Size casing set (in O.D.)	Weight lbs/ft.	Setting depth	Type cement	Sacks	Type and percent additives
Surface	12 1/2"	8 5/8"	20#	650	60/40 Pozmix Common	250 150	2% gel-3% CC 3% CC

LINER RECORD

PERFORATION RECORD

Top, ft.	Bottom, ft.	Sacks cement	Shots per ft.	Size & type	Depth interval

TUBING RECORD

Size	Setting depth	Packer set at

ACID, FRACTURE, SHOT, CEMENT SQUEEZE RECORD

Amount and kind of material used	Depth interval treated

Date of first production D & A	Producing method (flowing, pumping, gas lift, etc.)	Gravity
RATE OF PRODUCTION PER 24 HOURS	Oil bbls.	Gas MCF
Disposition of gas (vented, used on lease or sold)	Water %	Gas-oil ratio CFPB
	Perforations	

