

This form shall be filed in duplicate with the Kansas Corporation Commission, 200 Colorado Derby Building, Wichita, Kansas 67202, within ten days after the completion of the well, regardless of how the well was completed.

Attach separate letter of request if the information is to be held confidential. If confidential, only file one copy. Information on side one will be of public record and side two will then be held confidential.

Circle one: Oil Gas, Dry, SWD, OWWO, Injection. Type and complete ALL sections.

Applications must be filed for dual completion, commingling, SWD and injection, T.A.

Attach wireline logs (i.e. electrical log, sonic log, gamma ray neutron log, etc.). KCC # (316) 263-3238. (Rules 82-2-105 & 82-2-125)

OPERATOR PETROLEUM, INC.

API NO. 15-097-20,841-0000

ADDRESS Suite 800, 300 West Douglas
Wichita, Kansas 67202

COUNTY Kiowa
FIELD Nichols

**CONTACT PERSON Monte Chadd
PHONE 316-793-8471

PROD. FORMATION
LEASE Nichols 'D'

PURCHASER Koch Oil
ADDRESS Box 2256
Wichita, KS 67201

WELL NO. 1
WELL LOCATION App. C. N/2 NW SW

DRILLING DNB Drilling
CONTRACTOR
ADDRESS 515 R. H. Garvey Building
Wichita, Kansas 67202


3055 Ft. from north Line and
680 Ft. from west Line of
the SEC. 20 TWP. 29S RGE. 18W

WELL PLAT

PLUGGING CONTRACTOR
ADDRESS

RECEIVED
STATE CORPORATION COMMISSION

MAY 13 1982 5-13-82

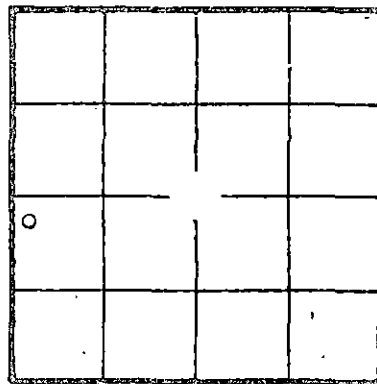

KCC
KGS
(Office Use)

TOTAL DEPTH 4990' CONSERVATION DIVISION

SPUD DATE 12-17-81 DATE COMPLETED 2-26-82

ELEV: GR 2238 DF KB 2243

DRILLED WITH (CANNY) (ROTARY) (SK) TOOLS

Amount of surface pipe set and cemented 598.96' DV Tool Used? No

A F F I D A V I T

STATE OF Kansas, COUNTY OF Barton SS, I, Terry Naylor OF LAWFUL AGE, BEING FIRST DULY SWORN UPON HIS OATH,

DEPOSES THAT HE IS Dist. Prod. Supt. Adm. (FOR)(OF) Petroleum, Inc.

OPERATOR OF THE Nichols 'D' LEASE, AND IS DULY AUTHORIZED TO MAKE

THIS AFFIDAVIT FOR AND ON THE BEHALF OF SAID OPERATOR, THAT WELL NO. 1 ON


SAID LEASE HAS BEEN COMPLETED AS OF THE 26 DAY OF February, 1982, AND THAT

ALL INFORMATION ENTERED HEREIN WITH RESPECT TO SAID WELL IS TRUE AND CORRECT.

FURTHER AFFIANT SAITH NOT.

(S) Terry Naylor

SUBSCRIBED AND SWORN BEFORE ME THIS 7 DAY OF May, 1982

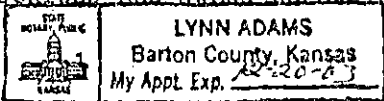

[Signature] NOTARY PUBLIC

MY COMMISSION EXPIRES: 12-20-83

**The person who can be reached by phone regarding any questions concerning this information. Within 45 days of completion, a witnessed initial test by the Commission is required if the well produces more than 25 BOPD or is located in a Basic Order Pool.