

STATE OF KANSAS
STATE CORPORATION COMMISSION

WELL PLUGGING RECORD

Give All Information Completely
Make Required Affidavit
Mail or Deliver Report to:
Conservation Division
State Corporation Commission
211 No. Broadway
Wichita, Kansas

Summer

County. Sec. 18 Twp. 33S Rge. 1W (E) (W)

Location as "NE/CNW/SW" or footage from lines: SE NE NE

Lease Owner Sunray Mid-Continent Oil Company

Lease Name Root Well No. 1

Office Address Box # 1878, Wichita, Kansas

Character of Well (completed as Oil, Gas or Dry Hole) Dry Hole

Date well completed July 4, 19 59

Application for plugging filed July 6, 19 59

Application for plugging approved July 7, 19 59


Plugging commenced July 4, 19 59

Plugging completed July 4, 19 59

Reason for abandonment of well or producing formation _____

If a producing well is abandoned, date of last production _____ 19 _____

Was permission obtained from the Conservation Division or its agents before plugging was commenced? yes

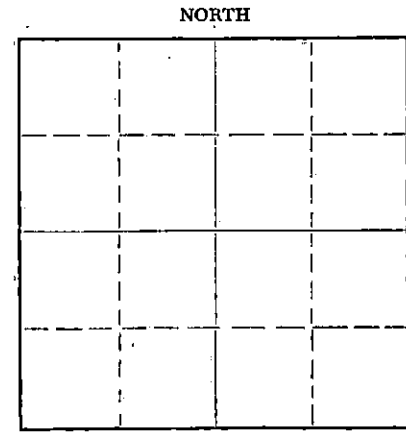

Locate well correctly on above Section Plat

Name of Conservation Agent who supervised plugging of this well Eugene Graham

Producing formation _____ Depth to top _____ Bottom _____ Total Depth of Well 4328 Feet

Show depth and thickness of all water, oil and gas formations.

OIL, GAS OR WATER RECORDS

CASING RECORD

FORMATION	CONTENT	FROM	TO	SIZE	PUT IN	PULLED OUT
				8 5/8"	250'	None

Describe in detail the manner in which the well was plugged, indicating where the mud fluid was placed and the method or methods used in introducing it into the hole. If cement or other plugs were used, state the character of same and depth placed, from _____ feet to _____ feet for each plug set.

Filled hole w/ drlg mud, set plug @ 240' w/ 15 sacks cement. Filled hole w/ drlg mud, set plug @ 28' w/ 8 sacks cement. Ran 2 sacks cement in rat hole. Plugging completed.

Log Attached.

RECEIVED
STATE CORPORATION COMMISSION
JUL 27 1959
22759
CONSERVATION DIVISION
Wichita, Kansas

(If additional description is necessary, use BACK of this sheet)

Name of Plugging Contractor Halliburton Oil Well Cementing Co.
Address _____

STATE OF KANSAS, COUNTY OF SEDGWICK, ss.
N. A. Gough (employee of owner) or (~~owner~~) of the above-described well, being first duly sworn on oath, says: That I have knowledge of the facts, statements, and matters herein contained and the log of the above-described well as filed and that the same are true and correct. So help me God.

(Signature) Nash A. Gough
Box # 1878, Wichita, Kansas
(Address)

SUBSCRIBED AND SWORN TO before me this 24 day of July, 19 59

My commission expires July 13, 1963

Notary Public

PLUGGING
FILE SEC. 18 T. 33 R. 1E
BOOK PAGE 48 LINE 10

Sunray Mid-Continent Oil Company
Tulsa, Oklahoma

Tulsa, Oklahoma
July 6, 1959

CONTRACTOR: Stickle Drilling Company
Drilling Commenced: June 16, 1959
Drilling Completed: July 4, 1959

Root #1 NE/4 Section 18-
33S-1W, Sumner County,
Kansas.

DRILLERS LOG

Depth Figure Indicate Base of Formation:

Surface	0
Sandy Shale	125
Shale & Shells	440
Shale & Lime	1210
Lime & Shale	1430
Shale & Lime	2074
Lime & Shale	2390
Lime	2490
Lime & Shale	2580
Shale	2815
Shale & Sand	2905
Sand & Shale	2965
Shale & Lime	3310
Lime	3390
Shale & Sand	3408
Lime & Shale	3526
Lime	3550
Lime & Shale	3695
Shale & Lime	3915
Lime & Shale	3950
Lime & Chert	3974
Lime	4152
Lime & Shale	4178
Lime	4237
Shale & Lime	4282
Lime & Shale	4300
Hard Sand	4301
Simpson Sand	4310
Sand	4328

RECEIVED
STATE COMMISSION
JUL 27 1959
CONSERVATION DIVISION
Wichita, Kansas

PLUGGING
FILE SEC 18 T 33 R 1E
BOOK PAGE 12 LINE 10

I, Fred E. Stickle hereby certify the above to be a true and complete Drillers Log of Sunray Mid-Continent Oil Company's Root #1 NE/4 Section 18-33S-1W, Sumner County, Kansas.

Fred E. Stickle
Fred E. Stickle

Lillian T. Bonham
Notary Public

February 13, 1960
My Commission Expires