


15-191-10004-0000

STATE OF KANSAS
STATE CORPORATION COMMISSION

Give All Information Completely
Make Required Affidavit
Mail or Deliver Report to:
Conservation Division
State Corporation Commission
211 No. Broadway
Wichita, Kansas

WELL PLUGGING RECORD

NORTH

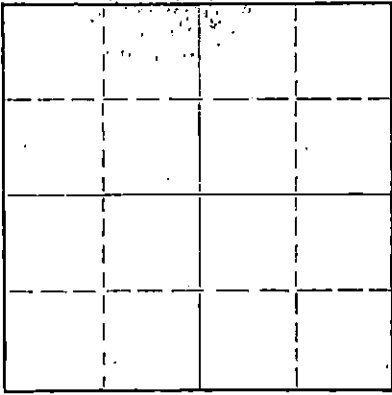

Locate well correctly on above
Section Plat

SUMNER County, Sec. 20 Twp. 33S Rge. 1W (E) (W)

Location as "NE/CNW/SW" or footage from lines SW SW NE

Lease Owner WALTERS DRILLING CO.

Lease Name FELT Well No. 1

Office Address 510 Orpheum Building, Wichita 2, Kansas

Character of Well (completed as Oil, Gas or Dry Hole) D & A

Date well completed May 24th, 1960 19

Application for plugging filed May 24th, 1960 19

Application for plugging approved May 24th, 1960 19

Plugging commenced May 24th, 1960 19

Plugging completed May 24th, 1960 19

Reason for abandonment of well or producing formation

If a producing well is abandoned, date of last production 19

Was permission obtained from the Conservation Division or its agents before plugging was commenced? YES

Name of Conservation Agent who supervised plugging of this well Lee N. Guthrie

Producing formation Depth to top Bottom Total Depth of Well 4305 Feet

Show depth and thickness of all water, oil and gas formations.

OIL, GAS OR WATER RECORDS

CASING RECORD

FORMATION	CONTENT	FROM	TO	SIZE	PUT IN	PULLED OUT
				805/8"	255'	-

Describe in detail the manner in which the well was plugged, indicating where the mud fluid was placed and the method or methods used in introducing it into the hole. If cement or other plugs were used, state the character of same and depth placed, from feet to feet for each plug set.

Filled with heavy mud to 240' set plug with 15 sx cement, thru drill pipe. Filled with heavy mud to 35' set solid bridge with 8 sx cement to base of cellar. Job complete 5-24-60

RECEIVED
STATE CORPORATION COMMISSION
MAY 27 1960
CONSERVATION DIVISION
Wichita, Kansas

(If additional description is necessary, use BACK of this sheet)

Name of Plugging Contractor WALTERS DRILLING CO.

Address 510 Orpheum Building, Wichita 2, Kansas

STATE OF KANSAS, COUNTY OF SEDGWICK, ss.

Robert F. Walters (employee of owner) or (owner or operator) of the above-described well, being first duly sworn on oath, says: That I have knowledge of the facts, statements, and matters herein contained and the log of the above-described well as filed and that the same are true and correct. So help me God.

(Signature) Robert F. Walters
Robert F. Walters, Partner in WALTERS DRILLING CO.
510 Orpheum Building, Wichita 2, Kansas
(Address)

SUBSCRIBED AND SWORN TO before me this 26 day of May, 1960

Patricia M. Edwards, Notary Public.

My commission expires August 11th, 1962.



DRILLER'S LOG

OPERATOR:	WALTERS DRILLING CO. 510 Orpheum Building Wichita 2, Kansas	FARM NAME:	#1 FELT
CONTRACTOR:	WALTERS DRILLING CO. 510 Orpheum Building Wichita 2, Kansas	LOCATION:	SW SW NE Sec. 20-33S-1W
CASING:	8-5/8" @ 255' (175 sx cmt)	COUNTY:	Sumner Co, Kansas
TOTAL DEPTH	4305'	COMMENCED:	May 9th, 1960
		COMPLETED:	May 24th, 1960
		ELEVATION:	1204' KB
		PRODUCTION:	D & A

FORMATION RECORD

Depths shown indicate the bottom of formations encountered.

Soil & Shale	255
Shale & Shells	375
Lime & Shale	1625
Shale & Lime	1775
Lime & Shale	2880
Sand & Shale	2950
Lime & Shale	3383
Lime	3435
Lime & Shale	3910
Lime	4110
Mississippi	4161
Lime & Shale	4302
Simpson Sand	4305
R.T.D.	4305

RECEIVED
STATE CORPORATION COMMISSION
MAY 27 1960
CONSERVATION DIVISION
Wichita, Kansas


CERTIFICATION

STATE OF KANSAS)
COUNTY OF SEDGWICK) SS:

I, Robert F. Walters, partner in Walters Drilling Co., hereby state upon oath, that the foregoing is a true and correct copy of the Driller's Log of the captioned well, to the best of my knowledge and ability.


Robert F. Walters

Subscribed and sworn to before me on this 26th day of May, 1960.

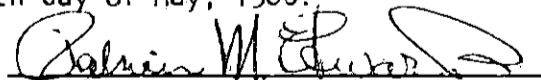
Patricia M. Edwards, Notary Public

My commission expires: August 11th, 1962.