


Give All Information Completely  
Make Required Affidavit  
Mail or Deliver Report to:  
Conservation Division  
State Corporation Commission  
211 No. Broadway  
Wichita, Kansas

WELL PLUGGING RECORD

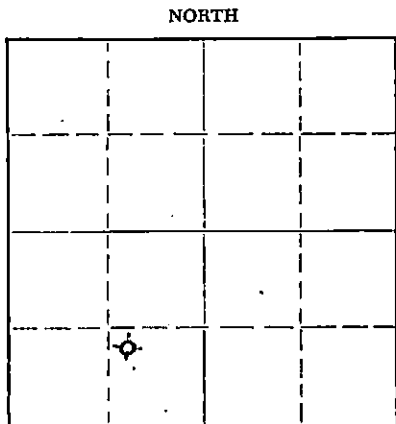

Locate well correctly on above  
Section Plat

Sumner County, Sec. 20 Twp. 33S Rge. (E) 1 (W)  
Location as "NE/CNW/SW" or footage from lines NW SE SW  
Lease Owner Walters Drilling Co.  
Lease Name Newlin Well No. 2  
Office Address 510 Orpheum Building, Wichita 2, Kansas  
Character of Well (completed as Oil, Gas or Dry Hole) Dry Hole  
Date well completed June 3, 1961 19  
Application for plugging filed June 3, 1961 (verbal) 19  
Application for plugging approved June 2, 1961 by letter 19  
Plugging commenced June 3, 1961 19  
Plugging completed June 3, 1961 19  
Reason for abandonment of well or producing formation

If a producing well is abandoned, date of last production 19

Was permission obtained from the Conservation Division or its agents before plugging was commenced? Verbal approval obtained from Lee N. Guthrie

Name of Conservation Agent who supervised plugging of this well Lee N. Guthrie

Producing formation \_\_\_\_\_ Depth to top \_\_\_\_\_ Bottom \_\_\_\_\_ Total Depth of Well \_\_\_\_\_ Feet

Show depth and thickness of all water, oil and gas formations.

OIL, GAS OR WATER RECORDS

CASING RECORD

FORMATION	CONTENT	FROM	TO	SIZE	PUT IN	PULLED OUT
				8 5/8"	227.22'	None

Describe in detail the manner in which the well was plugged, indicating where the mud fluid was placed and the method or methods used in introducing it into the hole. If cement or other plugs were used, state the character of same and depth placed, from \_\_\_\_\_ feet to \_\_\_\_\_ feet for each plug set.

Set bottom plug @ 180' with 15 sacks cement  
Set top plug @ 35' with 10 sacks cement

**RECEIVED**  
STATE CORPORATION COMMISSION  
JUN 8 1961  
CONSERVATION DIVISION  
Wichita, Kansas

(If additional description is necessary, use BACK of this sheet)  
Name of Plugging Contractor Walters Drilling Co.  
Address 510 Orpheum Building, Wichita, Kansas

STATE OF KANSAS, COUNTY OF SEDGWICK, ss.  
Robert F. Walters (owner or operator) of the above-described well, being first duly sworn on oath, says: That I have knowledge of the facts, statements, and matters herein contained and the log of the above-described well as filed and that the same are true and correct. So help me God.  
(Signature) Robert F. Walters  
510 Orpheum Building, Wichita 2, Kansas  
(Address)

SUBSCRIBED AND SWORN TO before me this 7th day of June, 1961

My commission expires January 4, 1964  
R. L. Abel Notary Public.

NEWLIN #2

LOCATION: NW SE SW Sec. 20-33S-1W  
Sumner County, Kansas

OPERATOR: Walters Drilling Co.

CONTRACTOR: Walters Drilling Co.

SURFACE CASING: 8-5/8" set @ 233'  
w/170 sacks cement

OIL STRING: None

Date Spudded: 5/19/61

Rotary Completion: 6/3/61

Elevation: 1197 GL  
1200 DF  
1202 KB

L O G

(Figures indicate bottom of formation)

Shale & Shells	0-490'
Shale & Lime	2825'
Shale & Sand	2858'
Sand	2955'
Shale & Lime	3310'
Lime	3380'
Sand	3386'
Sand & Lime	3390'
Lime	3585'
Shale & Lime	3885'
Lime	3969'
Lime & Chert	4009'
Lime	4026'
Lime & Chert	4056'
Lime	4077'
Lime	4102'
Lime	4185'
Shale & Lime	4225'
Shale	4272'
Sand	4280'
Total Depth	4280'

**RECEIVED**  
STATE CORPORATION COMMISSION

JUN 8 1961

CONSERVATION DIVISION  
Wichita, Kansas

The undersigned, Robert F. Walters, hereby certifies that the above log is a true and correct log of the formations encountered in drilling the above well as reflected by the Daily Drilling Reports.

WALTERS DRILLING CO.

by

Robert F. Walters  
ROBERT F. WALTERS, Partner

Subscribed and sworn to before me  
this 7th day of June, 1961

R. L. Abel  
R. L. ABEL, Notary Public

My commission expires January 4, 1964