

Give All Information Completely
Make Required Affidavit
Mail or Deliver Report to:
Conservation Division
State Corporation Commission
211 No. Broadway
Wichita, Kansas


WELL PLUGGING RECORD



SUMNER County. Sec. 20 Twp. 33S Rge. 1W (E) (W)

Location as "NE/CNW/SW" or footage from lines NW/4 SW/4 SE/4
Lease Owner Walters Drilling Co.
Lease Name Attebery Well No. 2
Office Address 510 Orpheum Building, Wichita 2, Kansas
Character of Well (completed as Oil, Gas or Dry Hole) Oilwell
Date well completed September 16th, 1960
Application for plugging filed May 24th, 1962
Application for plugging approved May 25th, 1962
Plugging commenced May 25th, 1962
Plugging completed May 28th, 1962
Reason for abandonment of well or producing formation Large increase in salt water

If a producing well is abandoned, date of last production November 19 60
Was permission obtained from the Conservation Division or its agents before plugging was commenced? Yes

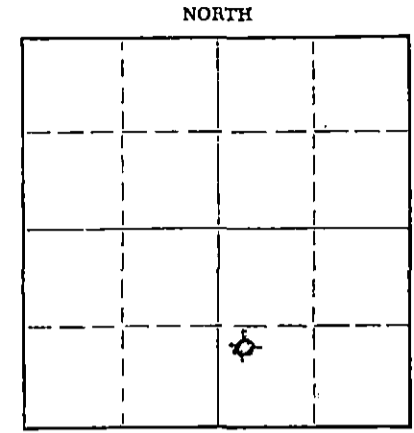

Locate well correctly on above Section Plat

Name of Conservation Agent who supervised plugging of this well Howard Hess
Producing formation Simpson Depth to top _____ Bottom _____ Total Depth of Well 4286 Feet
Show depth and thickness of all water, oil and gas formations.

OIL, GAS OR WATER RECORDS

CASING RECORD

FORMATION	CONTENT	FROM	TO	SIZE	PUT IN	PULLED OUT
None	None	0	257'	8-5/8"	257	None
Simpson	Oil	0	4282 1/2'	4-1/2"	4282 1/2'	2813.35

Describe in detail the manner in which the well was plugged, indicating where the mud fluid was placed and the method or methods used in introducing it into the hole. If cement or other plugs were used, state the character of same and depth placed, from _____ feet to _____ feet for each plug set.

Pulled pipe. Bailed hole to 280 ft. Set rock bridge, dumped 3-1/2 yards ready-mix cement in hole.

RECEIVED
STATE CORPORATION COMMISSION
6-22-62
JUN 23 1962

CONSERVATION DIVISION
Wichita, Kansas

(If additional description is necessary, use BACK of this sheet)

Name of Plugging Contractor Central Pipe Pulling Co.
Address 1416 Coolidge, Great Bend, Kansas

STATE OF KANSAS, COUNTY OF Sedgwick, ss.
Robert F. Walters (owner or operator) of the above-described well, being first duly sworn on oath, says: That I have knowledge of the facts, statements, and matters herein contained and the log of the above-described well as filed and that the same are true and correct. So help me God.
(Signature) Robert F. Walters
ROBERT F. WALTERS, Partner
510 Orpheum Building, Wichita 2, Kansas
(Address)

SUBSCRIBED AND SWORN to before me this 20th day of June, 1962

My commission expires May 28th, 1963

Ileen Penna
Ileen Penna
Notary Public.



DRILLER'S LOG

OPERATOR:	WALTERS DRILLING CO. 510 Orpheum Building Wichita 2, Kansas	FARM NAME:	#2 ATTEBERY
CONTRACTOR:	WALTERS DRILLING CO. 510 Orpheum Building Wichita 2, Kansas	LOCATION:	NW SW SE Sec. 20-33S-1W Sumner Co, Kansas
CASING RECORD:	8-5/8" @ 257' (150 sx) 4 1/2" @ 428 1/2' (200 sx)	ELEVATION:	1200' KB
TOTAL DEPTH:	4286'	COMMENCED:	6-16-60
		COMPLETED:	7-1-60
		PRODUCTION:	OIL - Simpson

FORMATION RECORD

Depths shown indicate bottom of formations encountered.

Soil, Shale & Shells	260
Lime & Shale	2775
Shale	2830
Shale & Sand	2945
Lime & Shale	3260
Lime & Sand	3300
Lime	3330
Lime & Shale	3900
Lime	4232
Shale & Lime	4282
Simpson	4286
R.T.D.	4286'

RECEIVED
CONSERVATION COMMISSION
JUN 22 1962
CONSERVATION DIVISION
Wichita, Kansas

CERTIFICATION

STATE OF KANSAS)
COUNTY OF SEDGWICK) SS:

I, R. L. Abel, of Walters Drilling Co., upon oath state that the above and foregoing is a true and correct copy of the Driller's Log of the Walters Drilling, et al #2 Attebery well.

R. L. Abel
R. L. Abel

Subscribed and sworn to before me this 5th day of July, 1960

Patricia M. Edwards
Patricia M. Edwards, Notary Public

My commission expires: August 11th, 1962.