


STATE OF KANSAS  
STATE CORPORATION COMMISSION  
CONSERVATION DIVISION  
P. O. BOX 17027  
WICKITA, KANSAS 67217

FORM CP-4

WELL PLUGGING RECORD

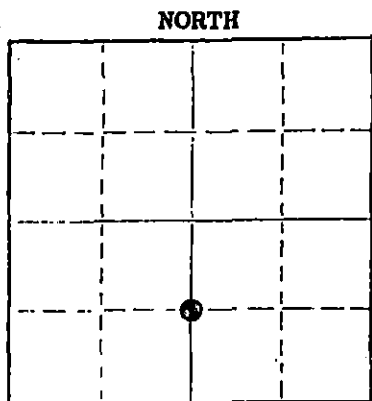

Locate well correctly on above Section Plot

Morton County, Sec. 34 Twp. 32 Rge. 42 ~~XX~~ (W)  
Location as "NE/CNW/SW" or footage from lines C S/2  
Lease Owner Colorado Oil Company  
Lease Name Neurburg Well No. 1-34  
Office Address 415 W. 8th St. - Suite 300, Amarillo, Texas 79101  
Character of Well (completed as Oil, Gas or Dry Hole) Gas  
Date well completed 1-7 19 55  
Application for plugging filed 12-23 19 75  
Application for plugging approved 12-26 19 75  
Plugging commenced 1-19 19 76  
Plugging completed 2-4 19 76  
Reason for abandonment of well or producing formation Replacement Well was drilled.  
If a producing well is abandoned, date of last production February 19 75  
Was permission obtained from the Conservation Division or its agents before plugging was commenced? Yes

Name of Conservation Agent who supervised plugging of this well Clarence Thomas  
Producing formation Greenwood Zones Depth to top 2721 Bottom 3228 Total Depth of Well 3506 Feet  
Show depth and thickness of all water, oil and gas formations.

OIL, GAS OR WATER RECORDS				CASING RECORD		
FORMATION	CONTENT	FROM	TO	SIZE	PUT IN	PULLED OUT
Wabaunsee	Gas & Water	2721	2952	8 5/8	651	none
Elmont	"	2952	3093	5 1/2	3501	1200
Topeka	"	3093	3212			
Lecompton	"	3212	3228			

Describe in detail the manner in which the well was plugged, indicating where the mud fluid was placed and the method or methods used in introducing it into the hole. If cement or other plugs were used, state the character of same and depth placed, from \_\_\_\_\_ feet to \_\_\_\_\_ feet for each plug set.

Pumped 250 sks. of cement @ 2490  
Pumped 20 sks. of cement @ 1200 to 1100  
Pumped 35 sks. of cement @ 650 to 550  
Put 15 sks. of cement @ 45 to 0

RECEIVED  
STATE CORPORATION COMMISSION  
3-4-76  
MAR 04 1976  
CONSERVATION DIVISION  
Wichita, Kansas

(If additional description is necessary, use BACK of this sheet)  
Name of Plugging Contractor Sargents Casing Pulling Service Kansas No. 511  
Address Box 506 Liberal, Kansas 67901

STATE OF TEXAS COUNTY OF POTTER, ss.

W. E. Rawlings (employee of owner) or (owner or operator) of the above-described well, being first duly sworn on oath, says: That I have knowledge of the facts, statements, and matters herein contained and the log of the above-described well as filed and that the same are true and correct. So help me God.

(Signature) W. E. Rawlings  
415 W. 8th St. - Suite 300, Amarillo, Texas 79101  
(Address)

Subscribed and sworn to before me this 2nd day of March, 19 76

My commission expires June 1, 1977  
Ruth A. Williamson  
Notary Public.

RECEIVED  
FEB 23 1976  
AMARILLO  
PRODUCTION