

15-129-20067-0000

STATE OF KANSAS
STATE CORPORATION COMMISSION


Form CP-4

WELL PLUGGING RECORD

Give All Information Completely
Make Required Affidavit
Mail or Deliver Report to:
Conservation Division
State Corporation Commission
212 No. Market
Wichita, Kansas

Morton County, Sec. 34 Twp. 32S Rge. 41W (W)
Location as "NE/CNW/4" or footage from lines C NE/4 NW/4
Lease Owner Ladd Petroleum Corporation
Lease Name Lemon "F" Well No. 1
Office Address P. O. Box 520, Great Bend, Kansas
Character of Well (completed as Oil, Gas or Dry Hole) Dry Hole
Date well completed January 8 19 71
Application for plugging filed January 8 19 71
Application for plugging approved January 8 19 71
Plugging commenced January 9 19 71
Plugging completed January 9 19 71
Reason for abandonment of well or producing formation _____

NORTH

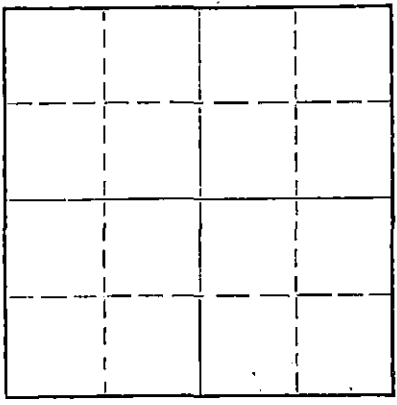

Locate well correctly on above Section Plat

If a producing well is abandoned, date of last production _____ 19 ____
Was permission obtained from the Conservation Division or its agents before plugging was commenced? Yes

Name of Conservation Agent who supervised plugging of this well Mr. Edgar J. Eves, Sublette, Kansas
Producing formation _____ Depth to top _____ Bottom _____ Total Depth of Well 5100 Feet
Show depth and thickness of all water, oil and gas formations.

OIL, GAS OR WATER RECORDS

CASING RECORD

FORMATION	CONTENT	FROM	TO	SIZE	PUT IN	PULLED OUT
				8 5/8"	1446'	None
RECEIVED STATE CORPORATION COMMISSION JAN 18 1971 CONSERVATION DIVISION Wichita, Kansas						

Describe in detail the manner in which the well was plugged, indicating where the mud fluid was placed and the method or methods used in introducing it into the hole. If cement or other plugs were used, state the character of same and depth placed, from _____ feet to _____ feet for each plug set.

Mud from 5100' to 1000'
Cement from 1000' to 900' With 35 Sacks Pozmix
Mud from 900' to 45'
Cement from 45' to 0' With 15 Sacks Pozmix


Job Complete @ 12:30

(If additional description is necessary, use BACK of this sheet)
Name of Plugging Contractor Earl F. Wakefield
Address 300 West Douglas, Suite 500 Wichita, Kansas 67202

STATE OF KANSAS, COUNTY OF SEDGWICK, ss.
Gordon L. Koelling (employee of owner) or (owner or operator) of the above-described well, being first duly sworn on oath, says: That I have knowledge of the facts, statements, and matters herein contained and the log of the above-described well as filed and that the same are true and correct. So help me God.

(Signature) Gordon L. Koelling
300 West Douglas, Suite 500, Wichita, Kansas (Address)

Subscribed and Sworn to before me this 15th day of January, 19 71
Carol Jean Noel
My commission expires October 22, 1972 Carol Jean Noel Notary Public.

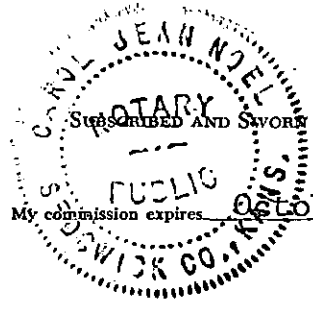

LEASE: LEMON "F" #1
OWNER: LADD PETROLEUM CORPORATION
CONT: EARL F. WAKEFIELD
COMM: 12-26-70
COMP: 1-9-71

LOCATION: C NE/4 NW/4
SECTION 34-T32S-R41W
MORTON COUNTY, KANSAS
CASING: 8 5/8" SET @ 1446'

Surface Clay & Sand	325
Red Bed	935
Anhydrite & Shale	1200
Shale & Shells	1448
Shale	1546
Shale & Shells	1935
Shale & Lime	2555
Lime	3045
Lime & Shale	3340
Lime	4240
Lime & Shale	4340
Lime	4525
Shale & Lime	4625
Lime	4800
Shale	5060
Shale & Lime	5100
R.T.D.	5100

RECEIVED
STATE CORPORATION COMMISSION
JAN 18 1971
CONSERVATION DIVISION
Wichita, Kansas

STATE OF KANSAS)
) as.
COUNTY OF SEDGWICK)

I, Gordon L. Koelling, do hereby certify that this is a true and correct log on the Lemon "F" #1, located NE/4 NW/4 Section 34-32S-41W, Morton County, Kansas, as shown by the daily drilling reports.

EARL F. WAKEFIELD

BY Gordon L. Koelling
Gordon L. Koelling

Subscribed and sworn to before me this 15th Day of January, 1971.

My Commission Expires:
October 22, 1972

Carol Jean Noel
Carol Jean Noel
Notary Public

