


STATE OF KANSAS
STATE CORPORATION COMMISSION

WELL PLUGGING RECORD

Give All Information Completely
Make Required Affidavit
Mail or Deliver Report to
Conservation Division
State Corporation Comm.
245 North Water
Wichita, KS 67202

Morton County, Sec. 35 Twp. 32S Rge. 41 ~~NE~~/W
Location as "NE/CNW/SW $\frac{1}{4}$ " or footage from lines
NE NW

Lease Owner Ladd Petroleum Corporation
Lease Name Bru Well No. #7-2
Office Address Box 2848 - 522 South Boston, Tulsa, Okla.
Character of Well (Completed as Oil, Gas or Dry Hole) Dry Hole

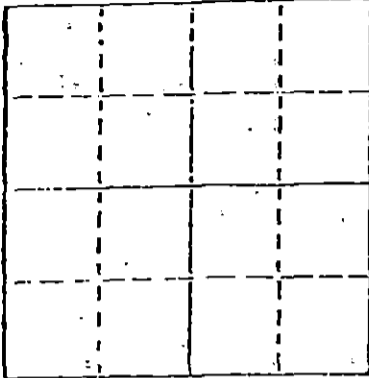

Locate well correctly on above
Section Plot

Date Well completed 4-8-82 19
Application for plugging filed 4-8-82 19
Application for plugging approved 4-8-82 19
Plugging commenced 4-8-82 19
Plugging completed 4-8-82 19

Reason for abandonment of well or producing formation
Commercial quantities of oil not found
If a producing well is abandoned, date of last production
19-

Was permission obtained from the Conservation Division or
its agents before plugging was commenced? Yes

Name of Conservation Agent who supervised plugging of this well Clarence Thomas, Jr.
Producing formation --- Depth to top --- Bottom --- Total Depth of Well 5098'
Show depth and thickness of all water, oil and gas formations.

OIL, GAS OR WATER RECORDS

CASING RECORD

FORMATION	CONTENT	FROM	TO	SIZE	PUT IN	PULLED OUT
				8 5/8"	1399'	None

Describe in detail the manner in which the well was plugged, indicating where the mud fluid
was placed and the method or methods used in introducing it into the hole. If cement or other
plugs were used, state the character of same and depth placed, from --- feet to
--- feet for each plug set.

- Plug @ 3250' w/25 sx.
- Plug @ 2800' w/25 sx.
- Plug @ 1350' w/40 sx.
- Plug @ 600' w/10 sx.
- Plug @ 40' w/10 sx.
- Rat Hole 10 sx.
- Mouse Hole 10 sx.

STATE CORPORATION COMMISSION
RECEIVED
APR 15 1982
CONSERVATION DIVISION
Wichita, Kansas

(If additional description is necessary, use BACK of this sheet)

Name of Plugging Contractor Rains & Williamson Oil Co., Inc.

STATE OF Kansas COUNTY OF Sedgwick, ss.
Wilson Rains, President of Rains & Williamson Oil Co. (employee of owner) or (owner or operator)
of the above-described well, being first duly sworn on oath, says: That I have knowledge of
the facts, statements, and matters herein contained and the log of the above-described well
as filed and that the same are true and correct. So help me God.

(Signature) Wilson Rains
435 Page Court, 220 W. Douglas, Wichita, Ks. 67202
(Address)

SUBSCRIBED AND SWORN TO before me this 12 day of April, 19 82

Juanita M. Green
Juanita M. Green Notary Public.

My commission expires 10-4-83



DRILLER'S LOG

COMPANY: Ladd Petroleum Corporation

SEC. 35 T. 32S R. 41W

LOC. NE NW

WELL NAME: Bru #7-2

COUNTY: Morton

RIG NO. #5

TOTAL DEPTH 5098'

ELEVATION

COMMENCED: 3-27-82

COMPLETED: 4-8-82

CONTRACTOR: Rains & Williamson Oil Co., Inc.

CASING RECORD:

SURFACE: 8 5/8" @ 1399' w/500 sx. Lite, 12 1/2# gilsonite, 3% cc. and 100 sx. Class H, 3% cc.

PRODUCTION: D&A

LOG

(Figures Indicate Bottom of Formations)

Shale & Redbed	392
Sand & Redbed	1019
Redbed	1414
Shale	2162
Shale & Lime	2435
Lime & Shale	2665
Shale & Lime	2833
Lime & Shale	4129
Shale & Lime	4210
Lime & Shale	5098
<u>ROTARY TOTAL DEPTH</u>	<u>5098</u>

RECEIVED
STATE CORPORATION COMMISSION
APR 15 1982
CONSERVATION DIVISION
Wichita Kansas

STATE OF Kansas)

COUNTY OF Sedgwick)


SS:

I, Wilson Rains, President of Rains & Williamson Oil Co., Inc.

upon oath state that the above and foregoing is a true and correct copy of the log of the

Bru #7-2 well.

Wilson Rains
Wilson Rains

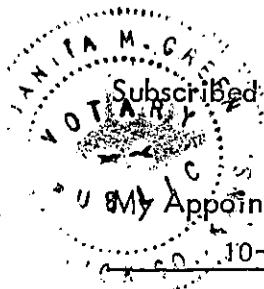

Subscribed and sworn to before me this 12 day of April, 1982.

My Appointment Expires: 10-4-83

Juanita M. Green
Juanita M. Green