

STATE OF KANSAS
STATE CORPORATION COMMISSION

Give All Information Completely
Make Required Affidavit
Mail or Deliver Report to:
Conservation Division
State Corporation Commission
211 No. Broadway
Wichita, Kansas

WELL PLUGGING RECORD

Stevens County. Sec. 4 Twp. 32 Rge. 38 (E) (W)

Location as "NE/CNW/SW" or footage from lines G NE

Lease Owner Anadarko Production Company

Lease Name McClure "D" Well No. 2

Office Address P. O. Box 351, Liberal, Kansas

Character of Well (completed as Oil, Gas or Dry Hole) Dry Hole

Date well completed October 18 19 62

Application for plugging filed October 19 19 62

Application for plugging approved October 23 19 62


Plugging commenced October 18 19 62

Plugging completed October 18 19 62

Reason for abandonment of well or producing formation Dry

If a producing well is abandoned, date of last production 19

Was permission obtained from the Conservation Division or its agents before plugging was commenced? Yes

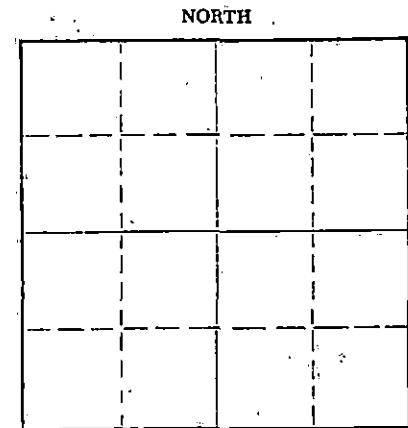

Locate well correctly on above Section Plat

Name of Conservation Agent who supervised plugging of this well Hugh E. Scott

Producing formation None Depth to top - Bottom - Total Depth of Well 6225 Feet

Show depth and thickness of all water, oil and gas formations.

OIL, GAS OR WATER RECORDS

CASING RECORD

FORMATION	CONTENT	FROM	TO	SIZE	PUT IN	PULLED OUT
				13 3/8"	590	
				8 5/8"	1739	

Describe in detail the manner in which the well was plugged, indicating where the mud fluid was placed and the method or methods used in introducing it into the hole. If cement or other plugs were used, state the character of same and depth placed, from _____ feet to _____ feet for each plug set.

Spotted 90 sacks from 2816' to 2400'; spotted 45 sacks from 707' to 627'; spotted 15 sacks from 40' to surface. Hole filled with heavy mud between plugs.

RECEIVED
STATE CORPORATION COMMISSION
10-31-62
OCT 31 1962

CONSERVATION DIVISION
Wichita, Kansas

(If additional description is necessary, use BACK of this sheet)

Name of Plugging Contractor Helmerich & Payne

Address First National Bank Building, Tulsa 3, Oklahoma

STATE OF Kansas, COUNTY OF Seward, ss.

S. H. Neithercoat (employee of owner) or ~~owner or operator~~ of the above-described well, being first duly sworn on oath, says: That I have knowledge of the facts, statements, and matters herein contained and the log of the above-described well as filed and that the same are true and correct. So help me God.

(Signature) S. H. Neithercoat

(Address)

SUBSCRIBED AND SWORN TO before me this 29th day of October, 19 62

Donald L. Vanjesson
Notary Public.

My commission expires _____

MY COMMISSION EXPIRES SEPT. 29, 1964

15-189-00044-0000

DRILLER'S LOG

WELL NAME McClure "D" #2 COMPANY OPERATING Anadarko Production Company

ADDRESS of COMPANY Box 351, Liberal, Kansas

WELL LOCATION C 1/2 NE 1/2

ft. North of South line,

ft. East of West line; Sec. 4 Twp. 32 Rge. 38, Stevens County, Kansas

DRILLING STARTED September 26, 1962 DRILLING COMPLETED October 18, 1962

WELL COMPLETED October 18, 1962 WELL CONNECTED _____, 19____

ELEVATION 3154.74 ft. Ground Level CHARACTER OF WELL (Oil, Gas, or Dry Hole) Dry Hole

OIL OR GAS SANDS OR ZONES - PERFORATIONS - ACIDIZING AND FRACTURING INFORMATION					
Name	From	To	No. of Shots	Gallons Used	Kind Used
NONE					

RECEIVED
 STATE CORPORATION COMMISSIONER
 OCT 31 1962
 CONSERVATION DIVISION
 WICHITA, KANSAS

CASING RECORD

Size	Amount Set	Sacks of Cement	Amount Pulled
13 3/8"	590'	375	
8 5/8"	1739'	100	

FORMATION RECORD

Formation	Top	Bottom	Formation	Top	Bottom
Sand	0	153	Shale & Lime	3058	3336
Sand & Shale	153	597	Lime	3336	3458
Sand & Red Bed	597	936	Lime & Shale	3458	3962
Red Bed & Shale	936	1141	Lime	3962	4033
Anhydrite & Gypsum	1141	1329	Lime & Chert	4033	4558
Sand & Anhydrite	1329	1710	Lime	4558	5112
Anhydrite & Lime	1710	1740	Lime & Shale	5112	5862
Lime	1740	2262	Lime	5862	5960
Shale & Anhydrite	2262	2702	Lime & Shale	5960	6019
Lime & Anhydrite	2702	2820	Lime	6019	6075
Shale & Lime	2820	2900	Lime & Chert	6075	6225
Lime	2900	3058	Total Depth	6225	

RESULTS of INITIAL PRODUCTION TEST: NONE