

STATE OF KANSAS
STATE CORPORATION COMMISSION

WELL PLUGGING RECORD


#78

Give All Information Completely
Make Required Affidavit
Mail or Deliver Report to:
Conservation Division
State Corporation Commission
800 Bittling Building
Wichita, Kansas

Sumner County. Sec. 12 Twp. 33 Rge. (E) 1 (W)

Location as "NE/CNW/SW" or footage from lines SE NE NW
Lease Owner Herndon Drilling Company
Lease Name Ray Rusk Well No. 1
Office Address Tulsa, Oklahoma
Character of Well (completed as Oil, Gas or Dry Hole) Dry hole
Date well completed 8-21 19 53
Application for plugging filed 8-21 19 53
Application for plugging approved 8-21 19 53
Plugging commenced 8-21 19 53
Plugging completed 8-21-53 19 53
Reason for abandonment of well or producing formation Dry hole

NORTH

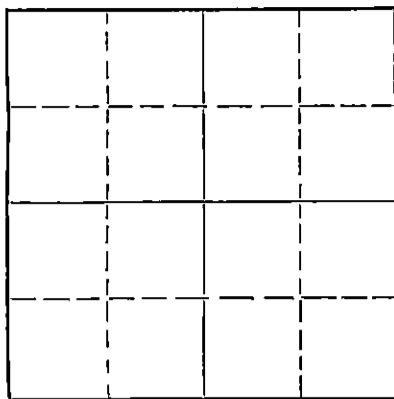

Locate well correctly on above
Section Plat

If a producing well is abandoned, date of last production 19
Was permission obtained from the Conservation Division or its agents before plugging was commenced? Yes

Name of Conservation Agent who supervised plugging of this well W. G. Buffington
Producing formation _____ Depth to top _____ Bottom _____ Total Depth of Well 4275 Feet
Show depth and thickness of all water, oil and gas formations.

OIL, GAS OR WATER RECORDS

CASING RECORD

FORMATION	CONTENT	FROM	TO	SIZE	PUT IN	PULLED OUT
				8-5/8	518	None

Describe in detail the manner in which the well was plugged, indicating where the mud fluid was placed and the method or methods used in introducing it into the hole. If cement or other plugs were used, state the character of same and depth placed, from _____ feet to _____ feet for each plug set.

Mud to 500 ft. Plug and bridge @ 500 ft. 15 sacks of cement on bridge. Mud to 30 ft. Plug and bridge @ 30 ft. Cemented to surface.

Plugging done by Halliburton

RECEIVED
STATE CORPORATION COMMISSION
9-1-53
CONSERVATION DIVISION
Wichita, Kansas

(If additional description is necessary, use BACK of this sheet)

Name of Plugging Contractor Herndon Drilling Company
Address Drawer 489, Tulsa, Oklahoma

STATE OF Oklahoma, COUNTY OF Tulsa, ss.
W. G. Prather (employee of owner) or (owner or operator) of the above-described well, being first duly sworn on oath, says: That I have knowledge of the facts, statements, and matters herein contained and the log of the above-described well as filed and that the same are true and correct. So help me God.

(Signature) W. G. Prather

SUBSCRIBED AND SWORN TO before me this 31st day of August, 19 53

My commission expires Sept. 19, 1956 Notary Public.

PLUGGING
FILE SEC 12-33-R-114
BOOK PAGE 124 LINE 12

WELL LOG ON RAY RUSK #1

Spudding date: 8/5/53
Date casing set: 8/5/53
Date rotary completed: 8/21/53
Date cable completed:

Location:
Sec. 12-33-1W - Sumner County, Kansas

FROM	TO	FORMATION	REMARKS
0	518	Surface Hole	Ran 17 Jts. 8-5/8" 24# Casing @ 518'
518	1485	Shale & Shells	Cemented w/ 300 sx. Bulk Cement
1485	2180	Shale & Lime	
2180	2415	Lime	
2415	3040	Shale & Lime	
3040	3175	Lime	
3175	3245	Shale & Lime	
3245	3685	Lime	
3685	3720	Lime & Shale Streaks	
3720	3765	Shale	
3765	3820	Shale & Lime	
3820	4275	Lime	
4275		Total Depth	

Plugged well:
Mud to 500 Ft.
Plug & Cement 540 Ft.
Mud to 30 Ft.
Cement & Plug to Surface

RECEIVED
STATE CORPORATION COMMISSION
SERIES
CONSERVATION DIVISION
Wichita, Kansas

PLUGGING
FILE SEC 12-33-1W
BOOK PAGE 124 LINE 12

Subscribed and sworn to before me this 26th
day of August 19 53

I certify the above and foregoing to be a true and exact
copy of the original driller's log on the RAY RUSK #1

Patsy M. Mearns
Notary Public
My commission expires: 4-22-57

HERNDON DRILLING COMPANY
C. J. Moore
By: _____
Title: Assistant Secretary