


STATE OF KANSAS
STATE CORPORATION COMMISSION

WELL PLUGGING RECORD

Give All Information Completely
Make Required Affidavit
Mail or Deliver Report to:
Conservation Division
State Corporation Commission
212 North Market, Insurance Bldg.
Wichita, Kansas

NORTH

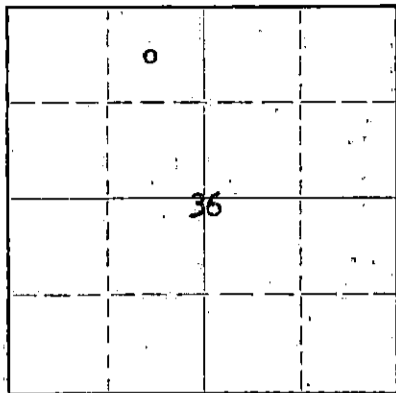

Locate well correctly on above
Section Plat

Stevens County, Sec. 36 Twp. 32 Rge. 37 (SE) (W)
Location as "NE/CNW/SW" or footage from lines 640' NL & 1960' WL of NW/4
Lease Owner Shell Oil Company APPROX E N E N W
Lease Name Lightcap Area 17 Well No. 1-36
Office Address Post Office Box 744 - Great Bend, Kansas
Character of Well (completed as Oil, Gas or Dry Hole) Dry Hole
Date well completed November 27, 19 59
Application for plugging filed December 8, 19 59
Application for plugging approved (Verbal) November 27, 19 59
Plugging commenced November 27, 19 59
Plugging completed November 28, 19 59
Reason for abandonment of well or producing formation _____

If a producing well is abandoned, date of last production _____ 19 ____
Was permission obtained from the Conservation Division or its agents before plugging was commenced? Yes

Name of Conservation Agent who supervised plugging of this well Frank Broadfoot
Producing formation Mississippian Depth to top 6125 Bottom _____ Total Depth of Well 6334 Feet
Show depth and thickness of all water, oil and gas formations.

OIL, GAS OR WATER RECORDS

CASING RECORD

FORMATION	CONTENT	FROM	TO	SIZE	PUT IN	PULLED OUT
Mississippian	Dry	6125	6334	8-5/8"	682'	None

Describe in detail the manner in which the well was plugged, indicating where the mud fluid was placed and the method or methods used in introducing it into the hole. If cement or other plugs were used, state the character of same and depth placed, from _____ feet to _____ feet for each plug set.

Hole full of heavy rotary mud. Pumped in 150 sax cement by Halliburton, leaving plug 2900-2420. Pushed 8-5/8" Halliburton plug to 567. Capped plug w/20 sax cement to 505. Pushed 8-5/8" Halliburton plug to 31. Capped plug w/10 sax cement to top.

6334 - 2900 PB w/mud
2900 - 2420 PB w/cement
2420 - 567 PB w/mud
567 - 505 PB w/cement
505 - 31 PB w/mud
31 - 0 PB w/cement

RECEIVED
STATE CORPORATION COMMISSION
12-10-1959
DEC 10 1959

CONSERVATION DIVISION
Wichita, Kansas

(If additional description is necessary, use BACK of this sheet)
Name of Plugging Contractor Company Rig No. 18 (W/Halliburton)
Address Post Office Box 744 - Great Bend, Kansas

STATE OF KANSAS COUNTY OF BARTON SS. _____
A. W. Weber (employee of owner) _____ of the above-described well, being first duly sworn on oath, says: That I have knowledge of the facts, statements, and matters herein contained and the log of the above-described well as filed and that the same are true and correct. So help me God.

(Signature) A W Weber
Post Office Box 744 - Great Bend, Kansas
(Address)

SUBSCRIBED AND SWORN TO before me this 8th day of December, 1959

My commission expires January 28, 1961 L. Mont Byers, Jr. Notary Public.

SHELL-LIGHTCAP Area 17 No. 1-36
 Approx. C NE NW Section 36-32S-37W
 640' NL & 1960' WL of NW 1/4
 Wildcat (Hugoton)
 Stevens County, Kansas

CASING RECORD

8 5/8" cem 682 with 450 sax; cement circulated.

- 0 - 595 surface
- Top Red Beds 595 (driller)
- 690 red beds
- 1510 red beds w/ anhydrite streaks
- 1955 shale, limestone, anhydrite & sand
- 1989 red bed w/ anhydrite
- 2276 shale & anhydrite
- 2411 shale & sand
- 2521 anhydrite, lime & shale
- 2657 shale & anhydrite
- 2857 shale
- 2962 lime
- 3084 shale & lime
- 3282 lime & shale
- 3312 shale w/ anhydrite
- 3500 shale & lime
- 3726 lime
- 3789 shale & lime
- 4038 lime
- 4125 shale & lime
- 4647 lime Top Heebner 4150
- 4748 shale & lime Top Toronto 4221
- 4849 lime & shale Top Lansing-Kansas City 4322
- 5243 lime Top Marmaton 5037
- 5426 lime w/ shale Top Cherokee 5232
- 5503 shale w/ lime
- 5609 shale w/s lime
- 5703 shale w/ lime
- 5729 shale w/s lime
- 6067 shale Top Morrow Shale 5736
- 6123 shale, lime & sand
- 6334 lime T.D.

RECEIVED
 STATE CORPORATION COMMISSION
 DEC 10 1959
 CONSERVATION DIVISION
 Wichita, Kansas

- Log Tops:
- Topeka 3354
 - Heebner 4139
 - Toronto 4208
 - Lansing-Kansas City 4316
 - Morrow Shale 5740
 - Morrow Sand 6042-6113;
 - 6043-52 & 6069-75 .9% porosity.
 - Chester 6125
 - St. Genevieve 6267

STATE OF KANSAS)
) SS
 COUNTY OF BARTON)

I hereby affirm that the above and foregoing is a true and correct copy of the drillers' log of the Lightcap Area 17 No. 1-36well, located in Section 36-32S-37W, Stevens County, Kansas.

Shell Oil Company

By A. W. Weber
 Superintendent

Subscribed and sworn to before me a Notary Public this 8th day of December, 1959.

My commission expires: January 28, 1961.

L. Mont Byers, Jr.
 Notary Public