


STATE OF KANSAS
STATE CORPORATION COMMISSION

WELL PLUGGING RECORD

Give All Information Completely
Make Required Affidavit
Mail or Deliver Report to:
Conservation Division
State Corporation Commission
212 North Market, Insurance Bldg.
Wichita, Kansas

Stevens County, Sec. 22 Twp. 32S Rge. 36(W)

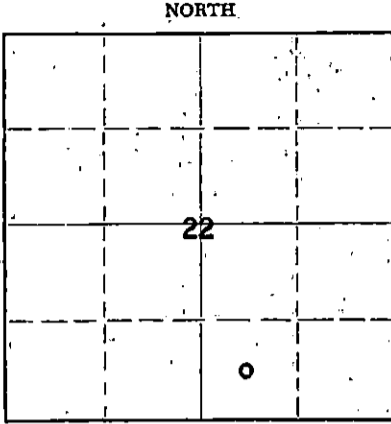

Locate well correctly on above
Section Plat

Location as "NE/CNW/SW" or footage from lines C SW SE
Lease Owner Shell Oil Company
Lease Name FINLEY Area 15 Well No. 1-22
Office Address P. O. Box 744, Great Bend, Kansas
Character of Well (completed as Oil, Gas or Dry Hole) Dry Hole
Date well completed October 5 19 59
Application for plugging filed November 4 19 59
Application for plugging approved (Verbal) October 5 19 59
Plugging commenced October 6 19 59
Plugging completed October 6 19 59
Reason for abandonment of well or producing formation _____

If a producing well is abandoned, date of last production _____ 19 _____
Was permission obtained from the Conservation Division or its agents before plugging was commenced? Yes

Name of Conservation Agent who supervised plugging of this well Merle A. Rives
Producing formation Mississippian Depth to top 6016 Bottom _____ Total Depth of Well 6293 Feet
Show depth and thickness of all water, oil and gas formations.

OIL, GAS OR WATER RECORDS

CASING RECORD

FORMATION	CONTENT	FROM	TO	SIZE	PUT IN	PULLED OUT

Describe in detail the manner in which the well was plugged, indicating where the mud fluid was placed and the method or methods used in introducing it into the hole. If cement or other plugs were used, state the character of same and depth placed, from _____ feet to _____ feet for each plug set.

Filled hole with mud to 2920 and pumped in 150 sax Pozmix cement to 2432. Filled hole with mud to 620, pushed Halliburton plug to 620 and pumped in 20 sax cement to 558. Filled hole with mud to 35 and pumped in 15 sax cement to 6' below surface.

STATE CORPORATION COMMISSION
NOV 9 1959
CONSERVATION DIVISION
Wichita, Kansas
11-9-1959

(If additional description is necessary, use BACK of this sheet)
Name of Plugging Contractor Company Rig No. 18 (w/ Halliburton)
Address P. O. Box 744, Great Bend, Kansas

STATE OF KANSAS COUNTY OF BARTON, ss.
A. W. Weber (employee of owner) of the above-described well, being first duly sworn on oath, says: That I have knowledge of the facts, statements, and matters herein contained and the log of the above-described well as filed and that the same are true and correct. So help me God.

(Signature) A. W. Weber
P. O. Box 744, Great Bend, Kansas
(Address)

SUBSCRIBED AND SWORN to before me this 4th day of November, 19 59
Lallmont Byers, Jr.
Notary Public.

My commission expires January 28, 1961

SHELL-FINLEY Area 15 No. 1-22
C SW SE Section 22-32S-36W
Wildcat (Hugoton)
Stevens County, Kansas

Casing Record

8-5/8" cem 722 with 475 sax. Cem. Circ.

- 0 - 732 sand, shale & red beds
- 1778 shale, sand & anhydrite
- 2122 shale
- 2467 shale & anhydrite
- 2575 shale & lime
- 2688 lime
- 2856 shale & lime
- 3049 lime
- 3147 lime w/ shale
- 3220 shale w/s lime
- 4024 lime
- 4281 lime & shale
 - Top Heebner 4120
 - Top Toronto 4168
 - Top Lansing-Kansas City 4271
- 4629 lime
- 4701 lime w/s shale
- 5005 lime Top Marmaton 4977
- 5066 shale
- 5121 shale & lime
- 5270 lime
- 5299 shale
- 5348 lime & shale
- 5565 shale
- 5669 shale & lime
- 5936 shale
- 5964 shale & lime
- 5996 sandstone (Morrow)
- 6024 shale & lime
- 6031 lime
- 6123 lime & shale
- 6197 shale & lime
- 6293 lime T.D.

STATE OF KANSAS)
) SS
COUNTY OF BARTON

I hereby affirm that the above and fore-going is a true and correct copy of the drillers' log of the Finley Area 15 No. 1-22 well, located in Section 22-32S-36W, Stevens County, Kansas.

Shell Oil Company

By A. W. Weber
Superintendent

Log tops: Heebner 4107
 Toronto 4158
 LKC 4261
 Morrow Shale 5663
 Mississippian:
 Chester 6016
 St. Genevieve 6203

Subscribed and sworn to before me a Notary Public this 4th day of November, 1959.

L. M. Byers Jr.
Notary Public

My commission expires: January 28, 1961.

NOV 9 1959

CONSERVATION DIVISION
Wichita, Kansas