

STATE OF KANSAS
STATE CORPORATION COMMISSION

WELL PLUGGING RECORD

Give All Information Completely.
Make Required Affidavit
Mail or Deliver Report to:
Conservation Division
State Corporation Commission
211 No. Broadway
Wichita, Kansas

Morton County, Sec. 7 Twp. 3 Rge. (E13) (W)

Location as "NE/CNW/SW" or footage from lines SW SW NE

Lease Owner Colorado Oil & Gas Corporation

Lease Name Dreyer Well No. 1-7

Office Address P.O. Box 158, Liberal, Kansas

Character of Well (completed as Oil, Gas or Dry Hole) Gas

Date well completed 8-9-54 19

Application for plugging filed 10-10-64 19

Application for plugging approved 11-10-64 19


Plugging commenced 11-11-64 19

Plugging completed 11-13-64 19

Reason for abandonment of well or producing formation Non-commercial

If a producing well is abandoned, date of last production 8-19 19 64

Was permission obtained from the Conservation Division or its agents before plugging was commenced? Yes

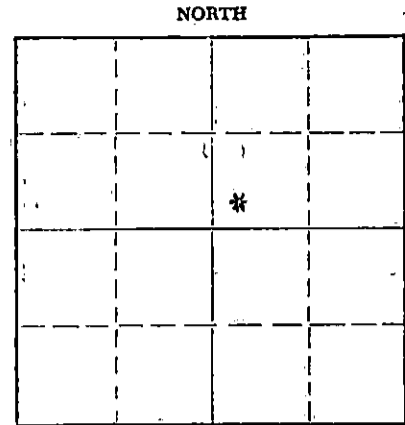

Locate well correctly on above Section Plat

Name of Conservation Agent who supervised plugging of this well Hugh Scott, Sublette, Kansas

Producing formation Topeka Depth to top Bottom Total Depth of Well 3165 Feet

Show depth and thickness of all water, oil and gas formations.

OIL, GAS OR WATER RECORDS

CASING RECORD

FORMATION	CONTENT	FROM	TO	SIZE	PUT IN	PULLED OUT
Lecompton	Gas	3277	3315	8-5/8"	622	none
Topeka	Gas	3140	3242	5-1/2	3410	2430

Describe in detail the manner in which the well was plugged, indicating where the mud fluid was placed and the method or methods used in introducing it into the hole. If cement or other plugs were used, state the character of same and depth placed, from feet to feet for each plug set.

Mix 20 sacks cement run on bottom to plug perforations at 3144. Run cement plug 3050 to 3030. Shot pipe at 2430. Filled hole with heavy mud. Run 35 sacks cement plug 650 to 550 and 15 sacks cement plug from 45 to 3. Cut 8-5/8" casing off at 3' below ground level, welded cap on top.

RECEIVED
STATE CORPORATION COMMISSION

NOV 24 1964
11-24-1964

CONSERVATION DIVISION
Wichita, Kansas

(If additional description is necessary, use BACK of this sheet)

Name of Plugging Contractor Sargents Casing Pulling Service

Address Box 506, Liberal, Kansas

STATE OF Kansas, COUNTY OF Seward, ss.

L.H. Walters (employee of owner) or (owner or operator) of the above-described

well, being first duly sworn on oath, says: That I have knowledge of the facts, statements, and matters herein contained and the log of the above-described well as filed and that the same are true and correct. So help me God.

(Signature) L.H. Walters

(Address)

SUBSCRIBED AND SWORN to before me this 23rd day of November, 1964

William B. Claunch
Notary Public.

My commission expires 11-1-66

Orig: Kansas Corp. Comm.
cc: Amerada Petroleum Co.
A.J. Smith
Colorado Interstate
R.G. Yarbrough

Colorado Oil & Gas Corporation
 Dreyer 1-7
 SW SW NE Section 7-32-43
 Morton County, Kansas

Spudded: 6-19-54 Holm Drilling Company
 Complete: 8-9-54
 Elevation: 3652 GL

CASING RECORD

8-5/8" set at
 5-1/2" set at
 TD 3435 GL; PBD 3165 GL

DRILLERS LOG

Surface Sand	0 to 290
Sand & Clay	460
Clay & Red Bed	610
Red Bed	900
Red Bed & Gypsum	990
Gypsum	1060
Red Bed & Anhydrite streaks	1370
Anhydrite	1690
Anhydrite & Shale	1900
Shale & Anhydrite	2310
Shale	2460
Shale & Lime	2690
Lime	2860
Lime & Shale	3015
Lime	3435 TD

RECEIVED
 STATE CORPORATION COMMISSION

NOV 12 1964

CONSERVATION DIVISION
 Wichita, Kansas