


STATE OF KANSAS
STATE CORPORATION COMMISSION

WELL PLUGGING RECORD

Give All Information Completely
Make Required Affidavit
Mail or Deliver Report to:
Conservation Division
State Corporation Commission
800 Bitting Building
Wichita, Kansas

Morton County. Sec. 8 Twp. 32 Rge. (E) 43(W)

NORTH

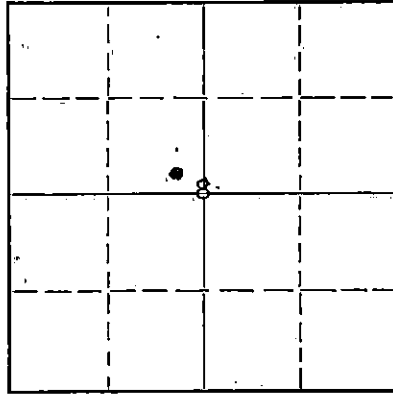

Locate well correctly on above Section Plat

Location as "NE/CNW/SW" or footage from lines SE SE NW
Lease Owner Colorado Oil & Gas Corporation
Lease Name Dreyer Well No. B-3
Office Address P.O. Box 158, Liberal, Kansas
Character of Well (completed as Oil, Gas or Dry Hole) Gas
Date well completed 10-29-54 19
Application for plugging filed 1-4-65 19
Application for plugging approved 1-5-65 19
Plugging commenced 1-5-65 19
Plugging completed 1-7-65 19
Reason for abandonment of well or producing formation Not economical to produce

If a producing well is abandoned, date of last production 12-31-64 19
Was permission obtained from the Conservation Division or its agents before plugging was commenced? Yes

Name of Conservation Agent who supervised plugging of this well Hugh Scott
Producing formation Greenwood Depth to top 3143 Bottom 3303 Total Depth of Well 3425 Feet
Show depth and thickness of all water, oil and gas formations.

OIL, GAS OR WATER RECORDS

CASING RECORD

FORMATION	CONTENT	FROM	TO	SIZE	PUT IN	PULLED OUT
Topeka		3143	50	8-5/8	612'	None
		3162	66	5-1/2	3396'	1300'
Lecompton		3230	35			
		3238	42			
U. Lecompton		3295	3303			

Describe in detail the manner in which the well was plugged, indicating where the mud fluid was placed and the method or methods used in introducing it into the hole. If cement or other plugs were used, state the character of same and depth placed, from feet to feet for each plug set.

20 sacks cement run on bottom filled to 3000',
Plug set at 3000'. Filled hole with heavy mud. Ran 35 sacks cement 650' to 550'. Filled hole and ran cement plug 45' to 3' below ground level. Cut 8-5/8" casing off at this point and welded. Cap on casing.

RECEIVED
STATE CORPORATION COMMISSION
JAN 15 1965
1-15-1965
CONSERVATION DIVISION
Wichita, Kansas

(If additional description is necessary, use BACK of this sheet)

Name of Plugging Contractor Sargent's Casing Pulling Service
Address Box 506, Liberal, Kansas

STATE OF Kansas, COUNTY OF Seward, ss.
L.H. Walters (employee of owner) or (owner or operator) of the above-described well, being first duly sworn on oath, says: That I have knowledge of the facts, statements, and matters herein contained and the log of the above-described well as filed and that the same are true and correct. So help me God.

(Signature) *L.H. Walters*
(Address)

SUBSCRIBED AND SWORN to before me this 14th day of January, 1965
William B. Claunch
Notary Public.

My commission expires 11-1-66

Orig: State Corp. Comm
cc: Amerada Petroleum Co
Colorado Oil & Gas -Denver
File


15-129-10042-0000

W. G. BUREAU--KANSAS GEOLOGICAL SURVEY
508 East Murdock, Wichita, Kansas

Company- COLORADO OIL & GAS & CITIES SERVICE OIL SEC. 8 T. 32 R. 43W
Farm- Dreyer "B" No. 3 SE SE NW

Total Depth. 3425'
Comm. 5-19-54 Comp. 5-28-54
Shot or Treated.
Contractor. Holm Dlr. a.
Issued. 2-19-55

County Morton KANSAS

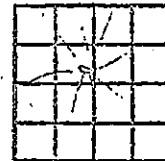

Elevation. 3617' RB

Production. open flow 2,940,000
R.P. 417#.

Figures indicate Bottom of Formations.

shale, clay	41
red bed, red rock	618
red bed; gyp	665
red bed, shells	1160
anhydrite	1190
shale & shells	1855
shale, lime shells	2044
lime & shale	3425
Total Depth	

Tops:	
Wabaunsee	2746
Elmont	2970
Topeka	3144
Lecompton	3283

Ran Micro Log

RECEIVED
STATE CORPORATION COMMISSION
FEB 18 1965
CONSERVATION DIVISION
Wichita, Kansas