


Give All Information Completely
Make Required Affidavit
Mail or Deliver Report to:
Conservation Division
State Corporation Commission
211 No. Broadway
Wichita, Kansas

WELL PLUGGING RECORD

NORTH

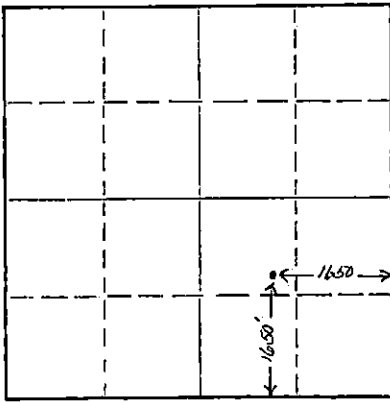

Locate well correctly on above Section Plat

MORTON County, Sec. 10 Twp. 32S Rge. 43W (E) - (W)
Location as "NE/CNW/SW" or footage from lines. CENTER SE NW SE
Lease Owner EDWIN L. COX
Lease Name E. WILSON Well No. 1
Office Address P. O. BOX 578 - HEALDTON, OKLAHOMA
Character of Well (completed as Oil, Gas or Dry Hole) DRY HOLE
Date well completed 12 - 24 - 1965
Application for plugging filed 12 - 29 - 1965
Application for plugging approved 12 - 27 - 1965
Plugging commenced 12 - 23 - 1965
Plugging completed 12 - 24 - 1965
Reason for abandonment of well or producing formation NO COMMERCIAL SHOW OF OIL OR GAS

If a producing well is abandoned, date of last production - - 19 - -
Was permission obtained from the Conservation Division or its agents before plugging was commenced? YES

Name of Conservation Agent who supervised plugging of this well MR. H. E. SCOTT
Producing formation - Depth to top - Bottom - Total Depth of Well 5386 Feet
Show depth and thickness of all water, oil and gas formations.

OIL, GAS OR WATER RECORDS

CASING RECORD

FORMATION	CONTENT	FROM	TO	SIZE	PUT IN	PULLED OUT
UPPER MORROW	NIL	4813	4822	8-5/8"	1408	NONE
MIDDLE MARMATON	NIL	3775	3785			

Describe in detail the manner in which the well was plugged, indicating where the mud fluid was placed and the method or methods used in introducing it into the hole. If cement or other plugs were used, state the character of same and depth placed, from _____ feet to _____ feet for each plug set.

PLUGGING PROCEDURE:

1. Set cement plug in bottom at 3350' W/100 sks. Pozmix.
 2. Set cement plug at 1400' W/35 sks. Pozmix.
 3. Set cement plug at 45' up to 5' below ground level W/15 sks. Pozmix.
- Hole filled W/drilling mud.

RECEIVED
STATE CORPORATION COMMISSION

JAN 3 1966

1-3-1966
CONSERVATION DIVISION
Wichita, Kansas

(If additional description is necessary, use BACK of this sheet)

Name of Plugging Contractor GARVEY DRILLING COMPANY
Address ROUTE #2 - GREAT BEND, KANSAS

STATE OF OKLAHOMA, COUNTY OF CARTER, ss.
J. L. Lee (employee of owner) ~~not a contractor~~ of the above-described well, being first duly sworn on oath, says: That I have knowledge of the facts, statements, and matters herein contained and the log of the above-described well as filed and that the same are true and correct. So help me God.

(Signature)

J. L. Lee
Div. Supt.
P. O. Box 578 - HEALDTON, OKLAHOMA
(Address)

SUBSCRIBED AND SWORN to before me this 29th day of December, 19 65

My commission expires 10-24-67

M. B. [Signature]
Notary Public.



DRILLERS LOG

E. WILSON # 1 (Plugged & Abandoned; See Form CP-4
 C SE NW SE prev. forwarded)
 Sec. 10, 32S, 43W
 Morton Co. Kansas

Depth		Formation
From	To	
0	140	Surface Sand
140	1184	Red Bed, Sand, Gyp
1184	1409	Sand, Shale & Gyp
1409	1416	Anhydrite
1416	2085	Shale & Shells
2085	5190	Lime & Shale
5190	5244	Lime
5244	5360	Lime & Shale
5360	5386	Lime

RECEIVED
 STATE CORPORATION COMMISSION

JAN 17 1966

CONSERVATION DIVISION
 Wichita, Kansas

RECEIVED

JAN 17

CONSERVATION
 Wichita, Ks.